


MICROFILMED

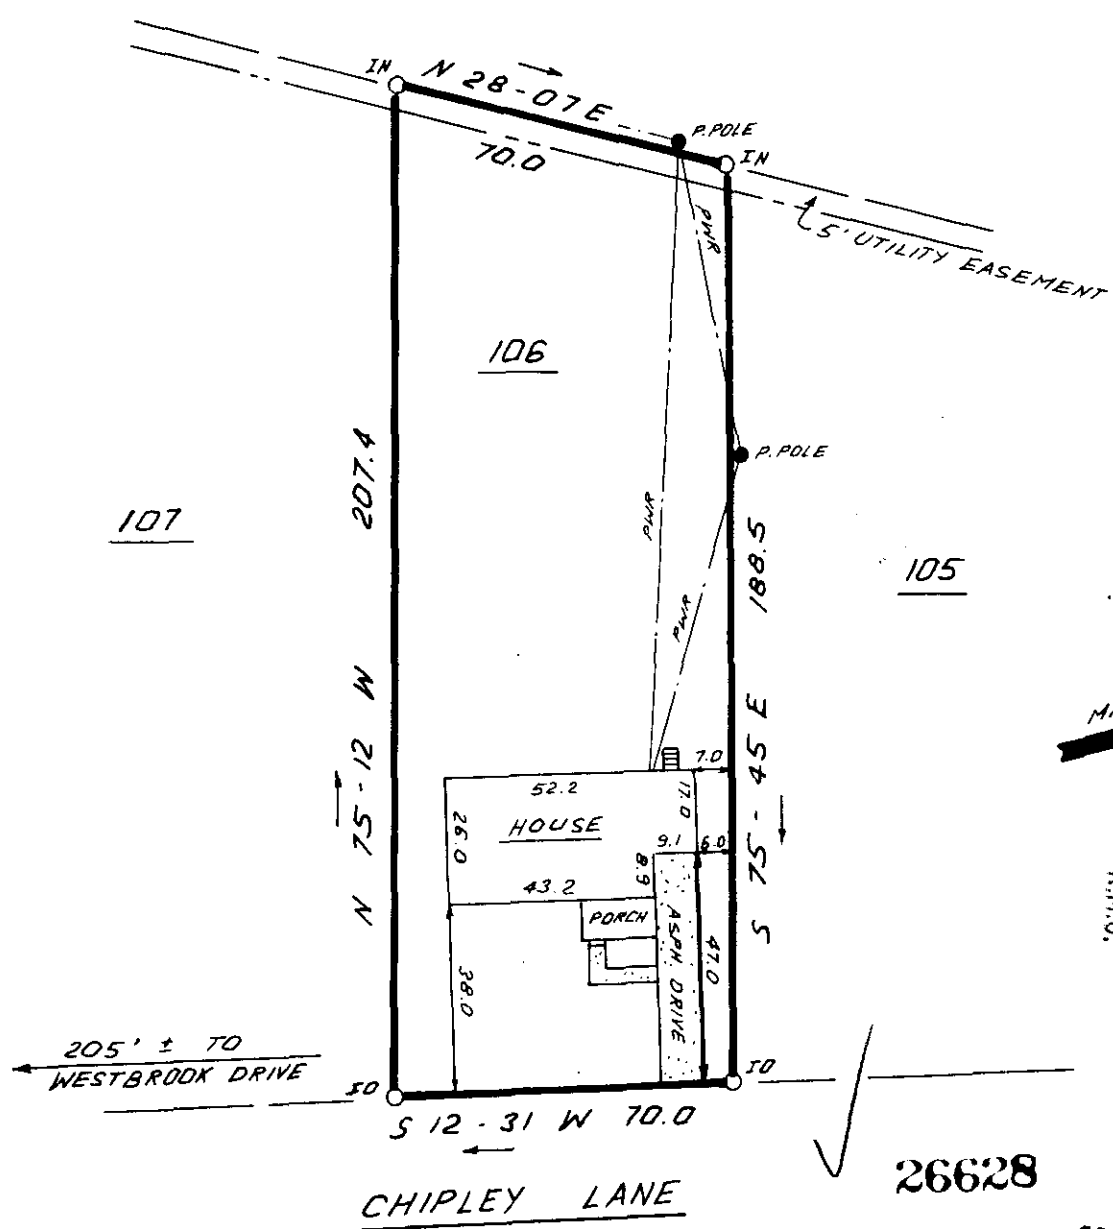

MAG NORTH
 FILED
 GREENVILLE CO. S.C.
 MAR 11 2 26 PM '85
 DONNIE S. JANKERSLEY
 R.M.O.

26628

MAR 11 1985

11-1-34



THIS IS TO CERTIFY THAT THE PROPERTY SHOWN ON THIS PLAT WAS SURVEYED UNDER MY DIRECT SUPERVISION PROPERTY LINES AND IMPROVEMENTS SHOWN ARE LOCATED CORRECTLY AND THAT NO VISIBLE ENCROACHMENTS EXIST UNLESS OTHERWISE SHOWN THIS PROPERTY IS NOT LOCATED IN A DESIGNATED FLOOD HAZARD AREA

ECTO -----1 MR11 85 028

3.0000

**STATE OF SOUTH CAROLINA
 GREENVILLE COUNTY**

FREELAND & ASSOCIATES
 Engineers • Land Surveyors
 318 WEST STONE AVENUE.
 GREENVILLE, S.C.
 (803) 271-4924

CHESTNUT HILLS
LOT 106
PROPERTY OF
LARRY SCOTT Mc GEE
ROSIE P. Mc GEE

PLAT BOOK	66 - 35
DEED BOOK	778 - 266
TAX MAP	102 - 2 - 165
PARTY CHIEF	B. G.
DRAWN	I. R.
DATE	10 - 25 - 84
DWG NO	11961