
RICE STREET

(FORMERLY HENRIETTA AVENUE)

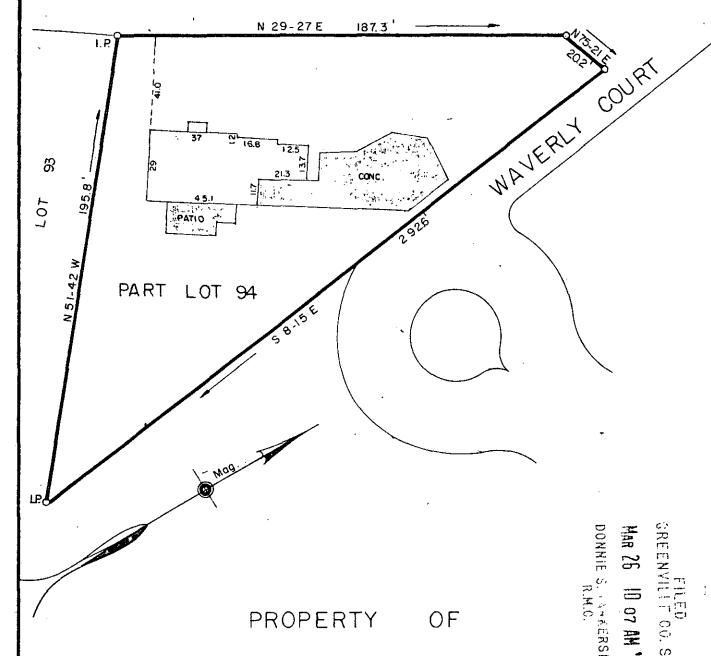

## THE SMITH COMPANIES A GENERAL PARTNERSHIP

GREENVILLE COUNTY, S.C.

Scale I" = 40' March, 1985

This is to certify that on the 7th day of March, 1985, we surveyed the property shown on this plat being known as Port 94 on plat of Augusta Road Ranches, recorded in plat book L, pages 52 & 53, Office of R.M.C., Greenville County, S.C.; and that the property lines, walls and buildings are as shown hereon; that the buildings located on said not do not encroach or project on adjacent streets or property and that no adjacent buildings or walls encroach or project on said premises; and from infromation from Greenville County, this structure is not located in a designated flood area.

11-J-95

DALTON & NEVES CO. INC. ENGINEERS

GCT0 -- 3 MR26 85 - 768

3.00CI

MICHUELLMED