


MICROFILMED

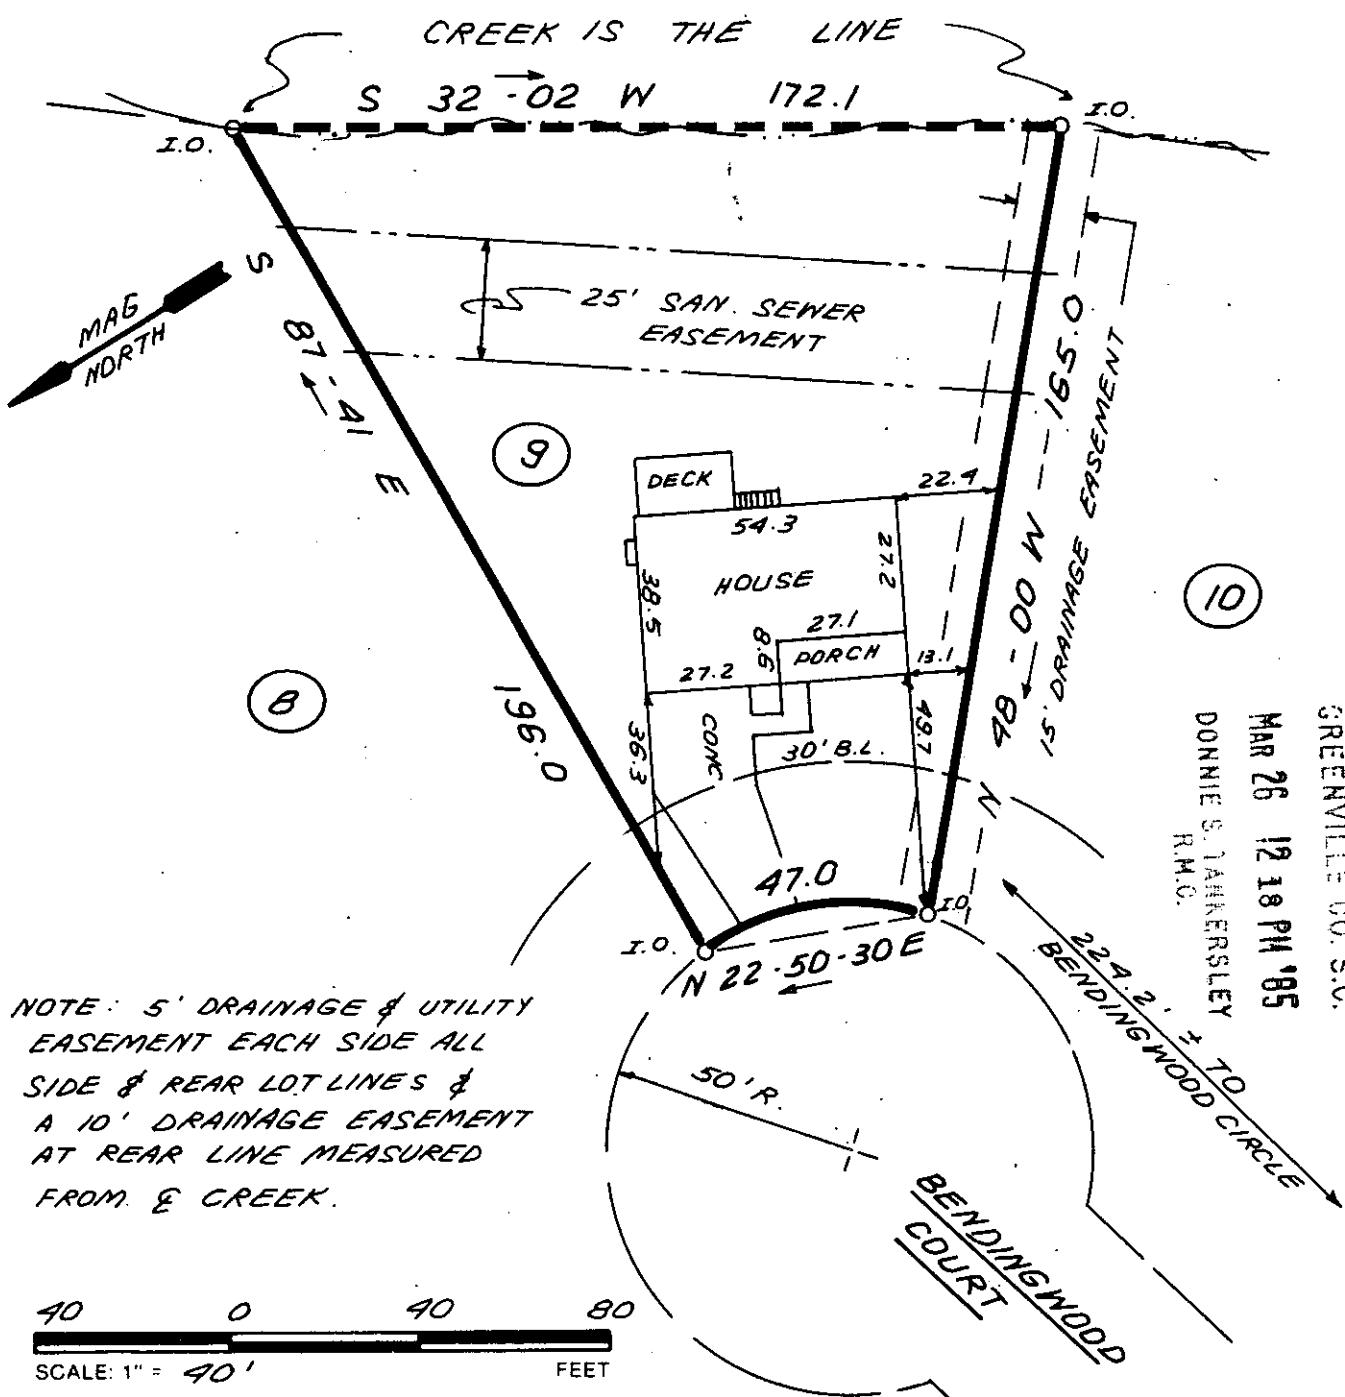

FILED
GREENVILLE CO. S.C.
MAR 26 12 18 PM '85
DONNIE S. JANKERSLEY
R.M.C.

NOTE: 5' DRAINAGE & UTILITY EASEMENT EACH SIDE ALL SIDE & REAR LOT LINES & A 10' DRAINAGE EASEMENT AT REAR LINE MEASURED FROM & CREEK.



THIS IS TO CERTIFY THAT THE PROPERTY SHOWN ON THIS PLAT WAS SURVEYED UNDER MY DIRECT SUPERVISION. PROPERTY LINES AND IMPROVEMENTS SHOWN ARE LOCATED CORRECTLY AND THAT NO VISIBLE ENCROACHMENTS EXIST UNLESS OTHERWISE SHOWN. THIS PROPERTY IS NOT LOCATED IN A DESIGNATED FLOOD HAZARD AREA.

11-3-98 28288 ✓

**STATE OF SOUTH CAROLINA
GREENVILLE COUNTY**

FREELAND & ASSOCIATES
Engineers • Land Surveyors
318 WEST STONE AVENUE.
GREENVILLE, S.C.
(803) 271-4924

NORTHWOOD
SEC. 3, LOT 9
PROPERTY OF
PAUL ANTHONY GILES &
SANDRA GAIL GILES

PLAT BOOK	9F@ 30
DEED BOOK	1211-519
TAX MAP	546.1-1-72
PARTY CHIEF	R.A.J.
DRAWN	K.E.G.
DATE	3-21-85
DWG. NO.	12657

SOUTH CAROLINA REGISTERED LAND SURVEYOR
4781
R. FREELAND
NO. 4781