MICROFILMED

FILED
GREENVILLE CO. S.C.
APR 1 3 49 PM '85
DONNIE S. TANKERSLEY
R.M.C.

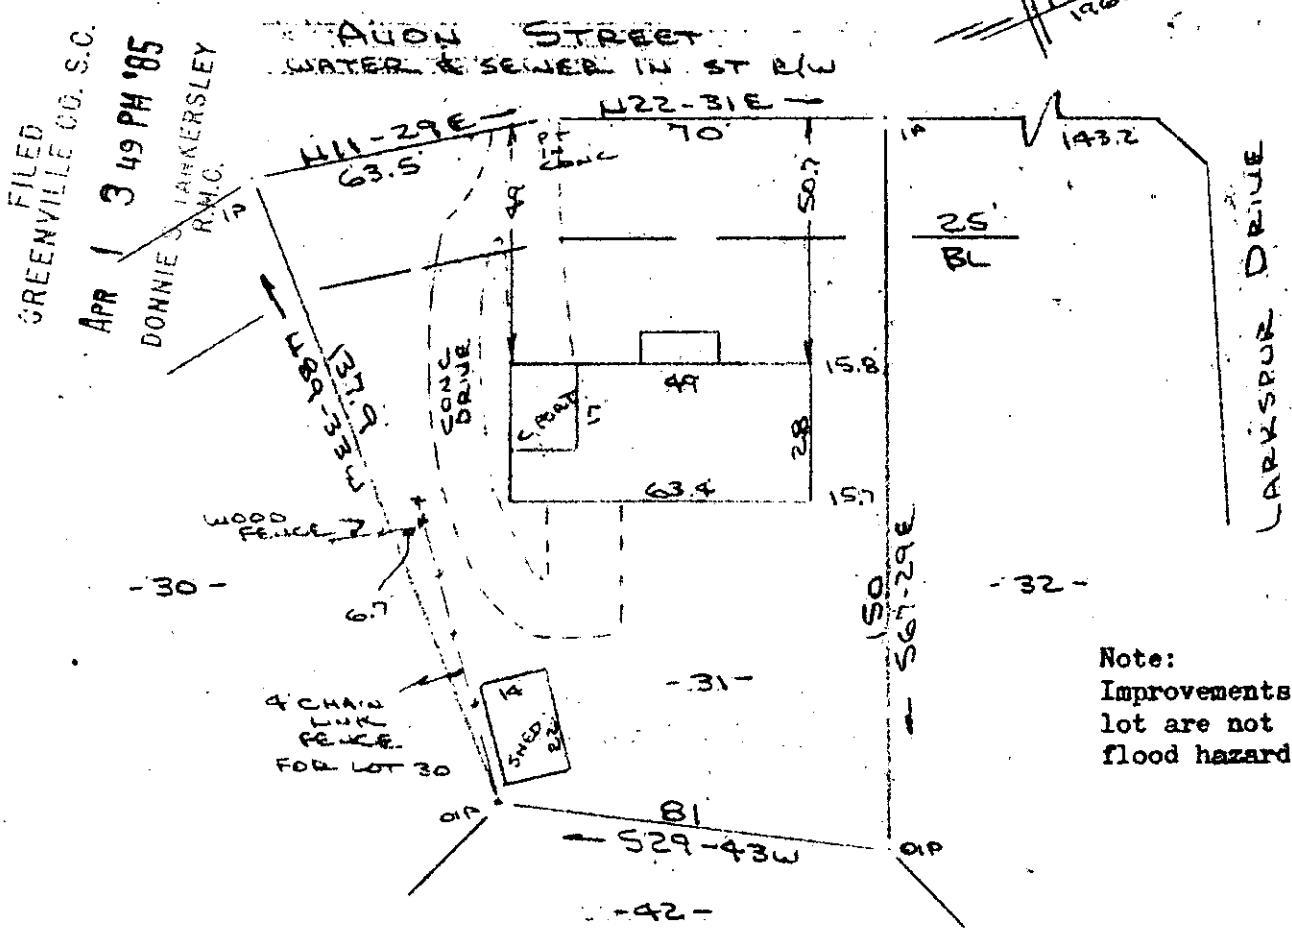


Note:
Improvements on this lot are not in a flood hazard area.

PROPERTY OF
VIRGIL C. ANDERSON
NEAR GREENVILLE, S.C.
SCALE: 1"=40 27 MAR 1985

40 20 0 40

This is to certify that on the 27th day of March, 1985, I surveyed the property shown on this plat, being known as lot 31 on plat of PROPERTY OF WM. R. TIMMONS, JR. and recorded in the RMC Office Greenville County, S. C., in Plat Book " XX " at Page 9; and that the property lines, walls and buildings are as shown hereon, and that the walls and buildings located on said lot do not encroach or project on adjacent street or property, and that no adjacent walls or buildings encroach or project on said premises, and no power lines cross this property except as shown hereon.

APR 1 1985

R. B. Bruce

R. B. Bruce, RLS # 1952

BOOK 1 APR 01 85 084

111L-45

29189

CAROLINA SURVEYING CO.
112 Manly St.
Greenville, S. C.

3.00CD

281/54

B13.2-1-91

Recordable Plat