


MICROFILMED

LEATHERWOOD, WALKER, TODD & MAIN

FILED
GREENVILLE CO., S.C.
MAR 4 28 PM '85
APPROVED
DONNIE RANKERSLEY
R.M.S.

8

9

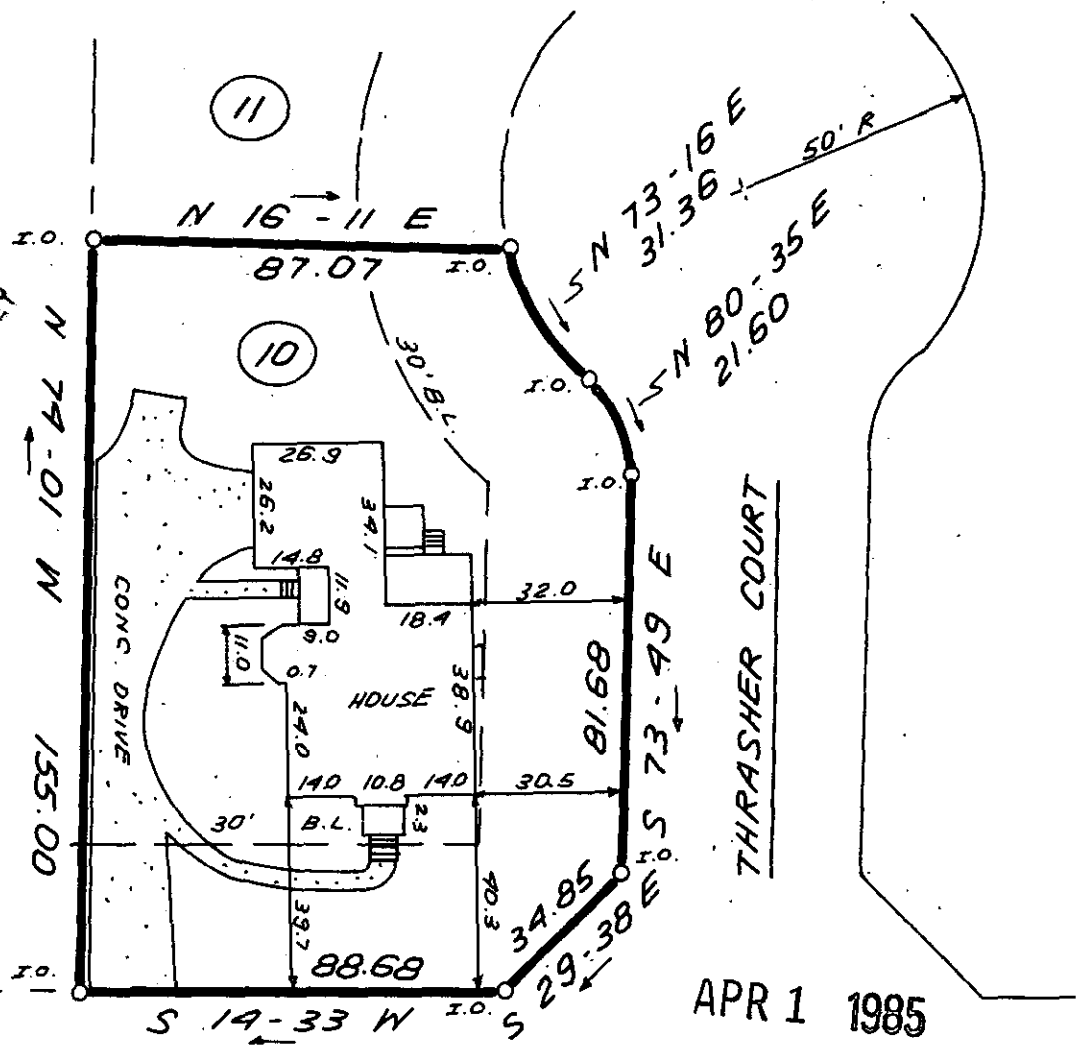


SANDPIPER LANE

11-L-56

APR 1 1985

29262

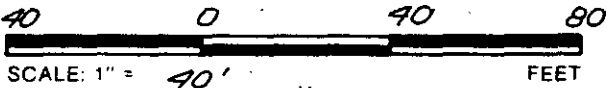

NOTE: 5' DRAINAGE & UTILITY EASEMENT ALONG EACH SIDE OF ALL SIDE & REAR LOT LINES.

THIS IS TO CERTIFY THAT THE PROPERTY SHOWN ON THIS PLAT WAS SURVEYED UNDER MY DIRECT SUPERVISION. PROPERTY LINES AND IMPROVEMENTS SHOWN ARE LOCATED CORRECTLY AND THAT NO VISIBLE ENCROACHMENTS EXIST UNLESS OTHERWISE SHOWN. THIS PROPERTY IS NOT LOCATED IN A DESIGNATED FLOOD HAZARD AREA.

STATE OF SOUTH CAROLINA
GREENVILLE COUNTY

FREELAND & ASSOCIATES
Engineers • Land Surveyors
318 WEST STONE AVENUE,
GREENVILLE, S.C.
(803) 271-4924

SOUTH CAROLINA
REGISTERED LAND SURVEYOR
4781
JAMES R. FREELAND
R.L.S. JAMES R. FREELAND
NO. 4781

FORRESTER WOODS
SEC VII, LOT 10
PROPERTY OF
JAMES RAY HARDISON
JUDY H. HARDISON

PLAT BOOK	10M @ 52
DEED BOOK	
TAX MAP	
PARTY CHIEF	J.E.C.
DRAWN	K.E.G.
DATE	3-19-85
DWG. NO.	12635