



17

30


29

18

20

21

19

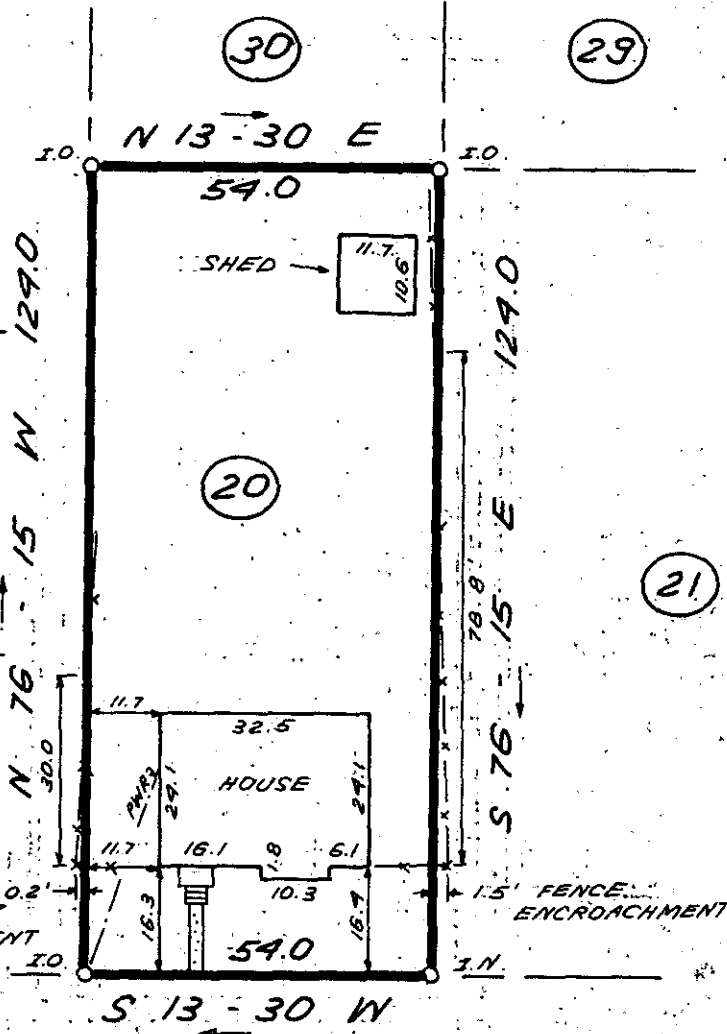


150' ± TO McCARY ST.

HERBERT STREET

11-6-68

29549

FILED
GREENVILLE CO. S.C.
APR 3 11 02 AM '95
DONNIE S. JANKERSLEY
R.M.C.

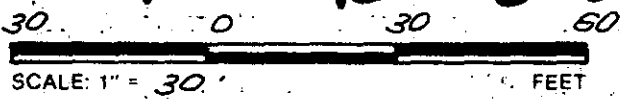

THIS IS TO CERTIFY THAT THE PROPERTY SHOWN ON THIS PLAT WAS SURVEYED UNDER MY DIRECT SUPERVISION. PROPERTY LINES AND IMPROVEMENTS SHOWN ARE LOCATED CORRECTLY AND THAT NO VISIBLE ENCROACHMENTS EXIST UNLESS OTHERWISE SHOWN. THIS PROPERTY IS NOT LOCATED IN A DESIGNATED FLOOD HAZARD AREA.

923

JAMES R. FREELAND
REGISTERED LAND SURVEYOR
SOUTH CAROLINA
NO. 4781

**STATE OF SOUTH CAROLINA
GREENVILLE COUNTY**

ELIZABETH HEIGHTS
LOT 20
PROPERTY OF
KEITH STIDHAM
BETH STIDHAM

FREELAND & ASSOCIATES
Engineers • Land Surveyors
318 WEST STONE AVENUE.
GREENVILLE, S.C.
(803) 271-4924

PLAT BOOK	F# 298
DEED BOOK	1107-573
TAX MAP	156-5-32
PARTY CHIEF	J.E.C.
DRAWN	K.E.G.
DATE	3-29-85
DWG. NO.	12729