


GREENVILLE CO. S.C.
MAG.
NORTH
APR 25 2 40 PM '85
DONNIE'S TANKERSLEY
R.M.C.

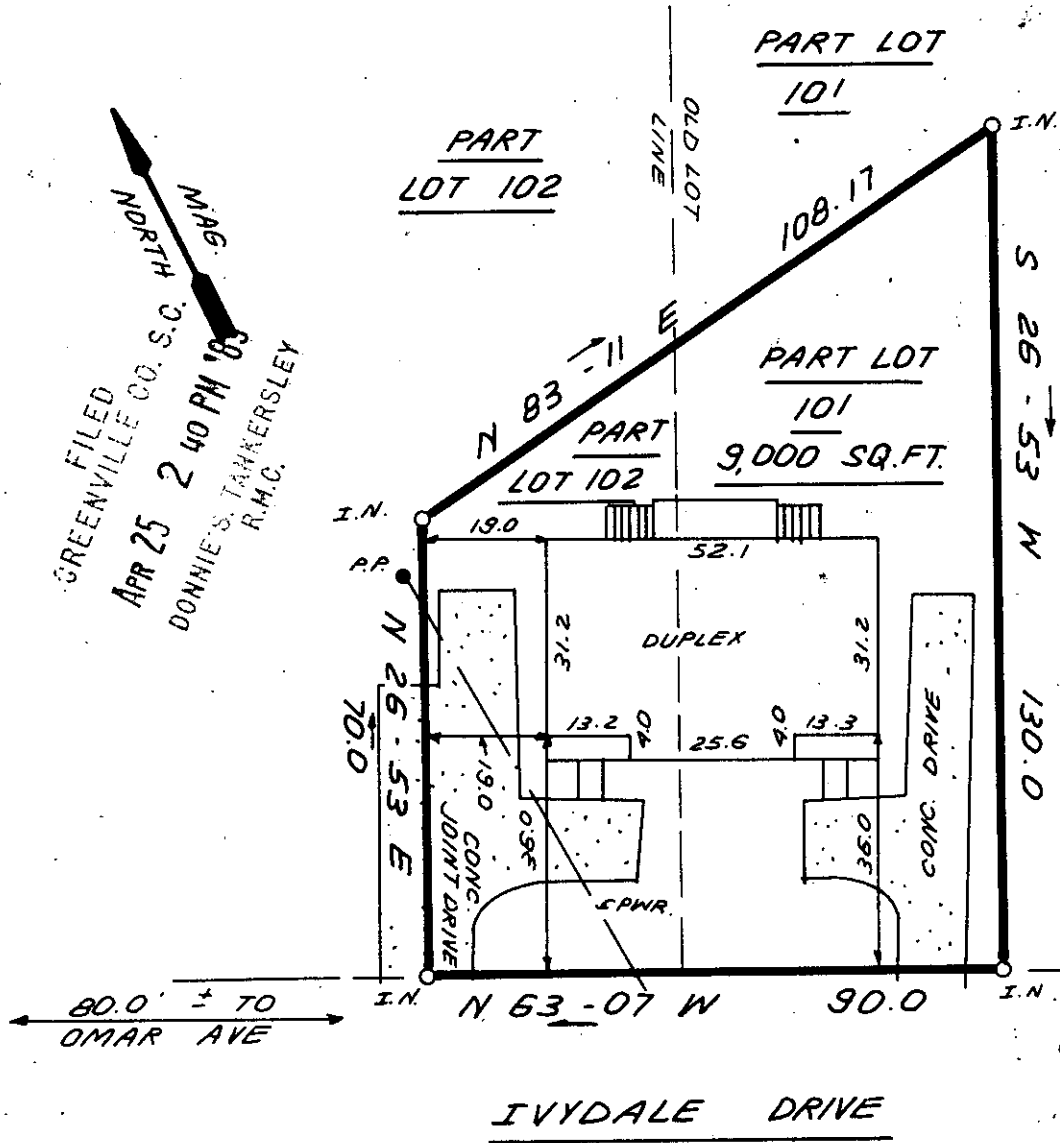


APR 25 1985

11-M-42

32054



THIS IS TO CERTIFY THAT THE PROPERTY SHOWN ON THIS PLAT WAS SURVEYED UNDER MY DIRECT SUPERVISION. PROPERTY LINES AND IMPROVEMENTS SHOWN ARE LOCATED CORRECTLY AND THAT NO VISIBLE ENCROACHMENTS EXIST UNLESS OTHERWISE SHOWN. THIS PROPERTY IS NOT LOCATED IN A DESIGNATED FLOOD HAZARD AREA.

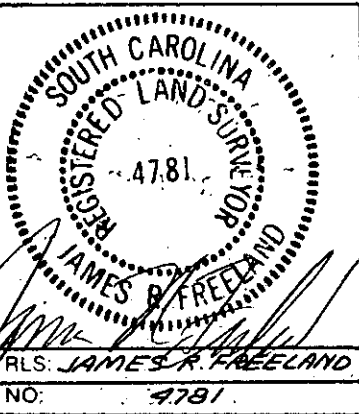

**STATE OF SOUTH CAROLINA
GREENVILLE COUNTY**

FREELAND & ASSOCIATES
Engineers • Land Surveyors
318 WEST STONE AVENUE.
GREENVILLE, S.C.
(803) 271-4924

PIEDMONT ESTATES
PART LOTS 101 & 102
PROPERTY OF
LOLLIE G. GIBSON
D. B. FLEMING

PLAT BOOK	M@ 123
DEED BOOK	1139-126
TAX MAP	
PARTY CHIEF	J.E.C.
DRAWN	K.E.G.
DATE	4-1-85
DWG. NO.	12734-1