


FILED
GREENVILLE CO. S.C.
APR 26 4 20 PM '85
DONNIE W. WALKERSLEY
S.M.C.

APR 26 1985

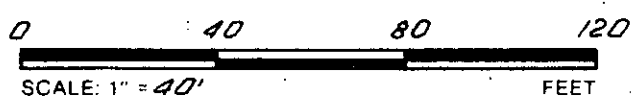

11-M-55-32297

THIS IS TO CERTIFY THAT THE PROPERTY SHOWN ON THIS PLAT WAS SURVEYED UNDER MY DIRECT SUPERVISION PROPERTY LINES AND IMPROVEMENTS SHOWN ARE LOCATED CORRECTLY AND THAT NO VISIBLE ENCROACHMENTS EXIST UNLESS OTHERWISE SHOWN. THIS PROPERTY IS NOT LOCATED IN A DESIGNATED FLOOD HAZARD AREA

SOUTH CAROLINA REGISTERED LAND SURVEYOR
4781
JAMES R. FREELAND
S.M.C.
J.R. Freeland
S.M.C.
SLS: JAMES R. FREELAND
NO: 4781

**STATE OF SOUTH CAROLINA
GREENVILLE COUNTY**

HOMESTEAD ACRES
SEC. 2, LOT 108, PART LOT 109

PROPERTY OF
WILLIAM R. BROTHERS
DEBORAH C. BROTHERS

FREELAND & ASSOCIATES
Engineers • Land Surveyors
318 WEST STONE AVENUE.
GREENVILLE, S.C.
(803) 271-4924

| | |
|-------------|--------------|
| PLAT BOOK | XX - 143 |
| DEED BOOK | 1234 - 263 |
| TAX MAP | P.16.1-1-380 |
| PARTY CHIEF | L.T. |
| DRAWN | I.R. |
| DATE | 4-24-85 |
| DWG NO. | 12867-0001 |