MICROFILMED

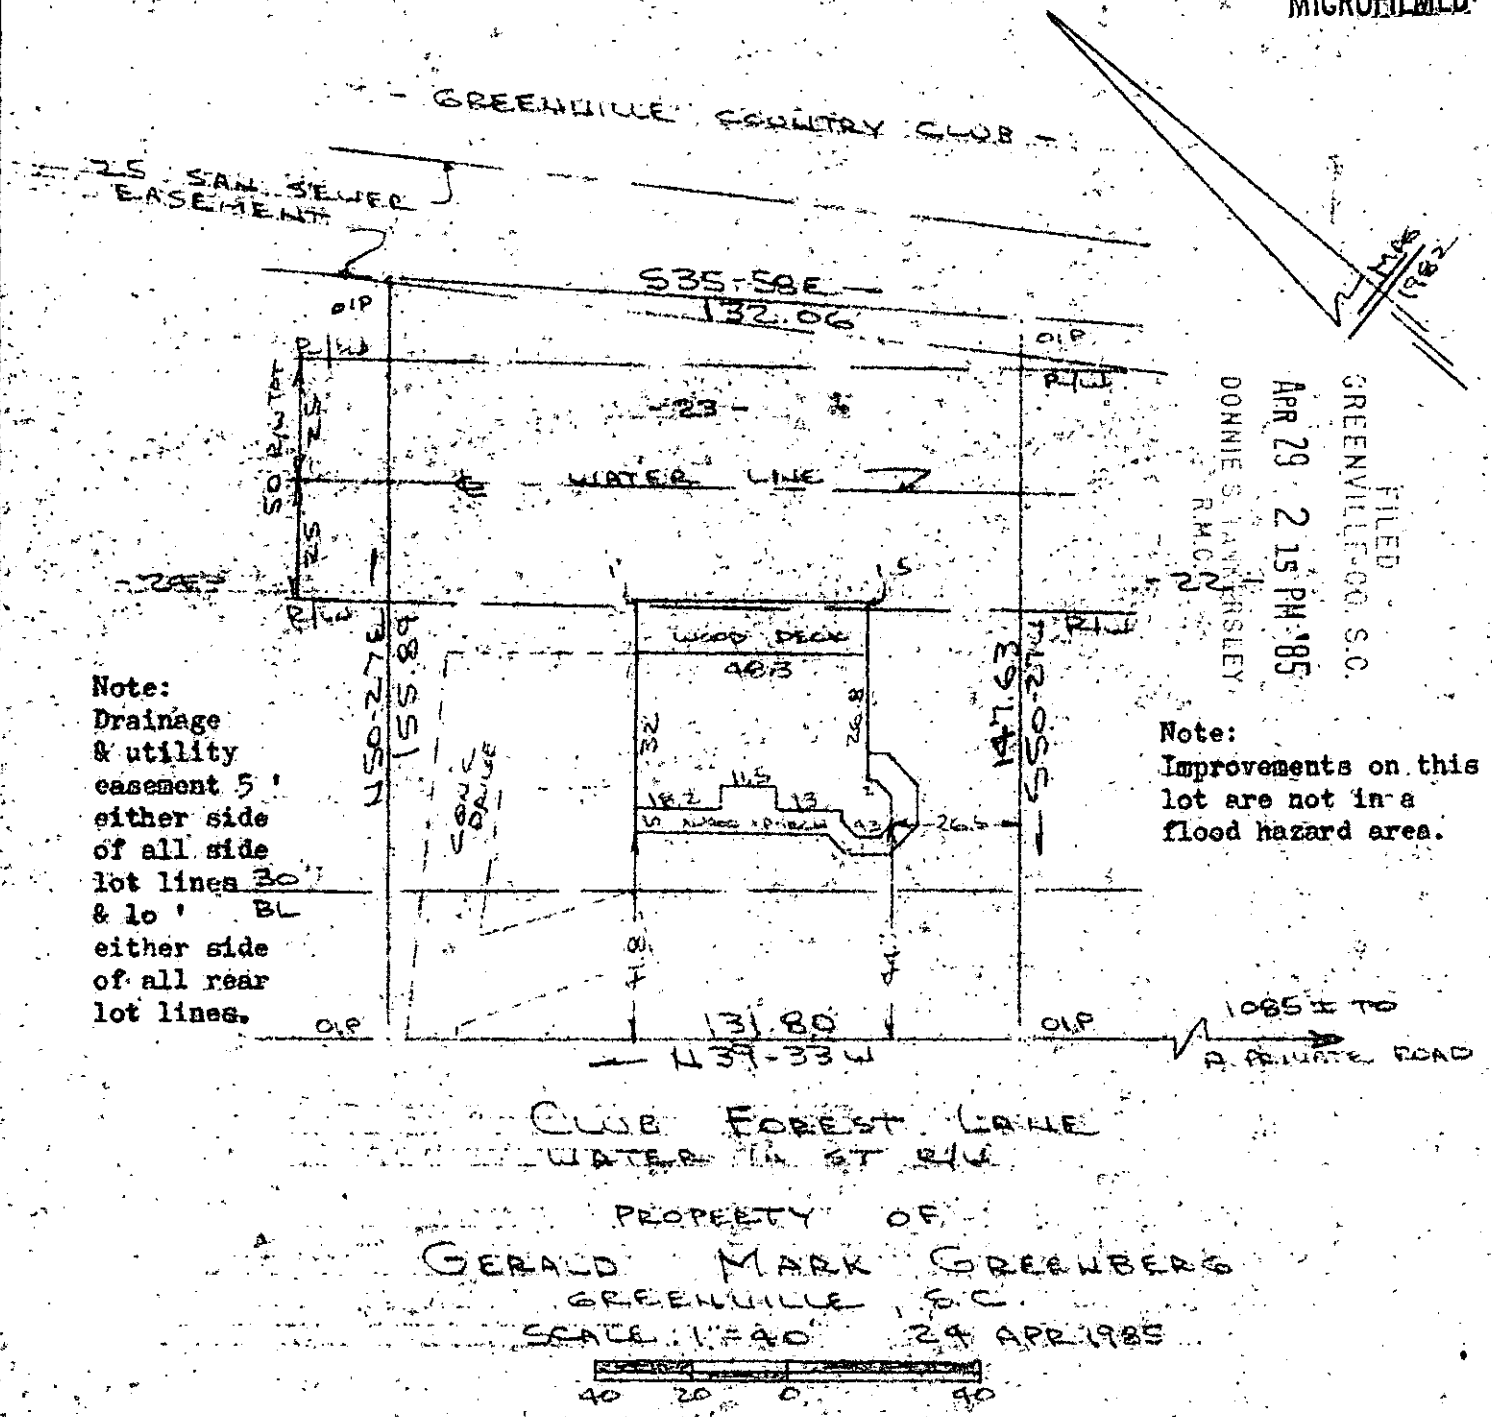

This is to certify that on the 24th day of April, 1985, I surveyed the property shown on this plat, being known as lot 23 on plat of CLUB FOREST Sheet 1 of 3 and recorded in the RMC Office Greenville County, S. C., in Plat Book " 9 - F " at Page 15; and that the property lines, walls and buildings are as shown hereon, and that the walls and buildings located on said lot do not encroach or project on adjacent street or property, and that no adjacent walls or buildings encroach or project on said premises, and no power lines cross this property except as shown hereon.

APR 29 1985

11-M-60

32529

R. B. Bruce, RLS # 1952

Recordable Plat

CAROLINA SURVEYING CO.
112 Manly St., Greenville, S. C.

3 APR 29 85 442 3.00CI