


MICROFILMED

FRONT STREET
WATER & SEWER IN S.W.

Note:
Improvements
on this lot are
not in a flood
hazard area.

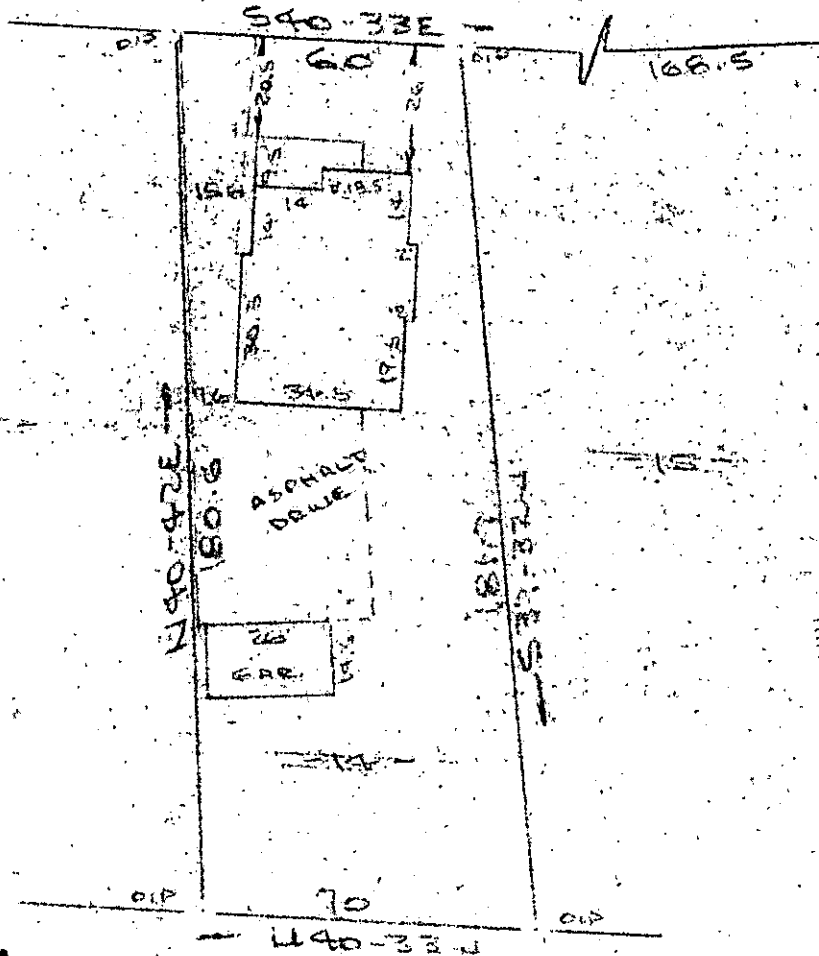

FILED
GREENVILLE CO. S.C.
APR 30 11 24 AM '85
DONNIE S. JANKERSLEY
R.M.C.

32631 ✓

11-M-75

PROPERTY OF
RICHARD H. QUINN JR. & MARTHA WILSON QUINN
GREENVILLE, S.C.
SCALE 1" = 40' APR 1985

APR 30 1985

This is to certify that on the 29th day of April, 1985, I surveyed the property shown on this plat, being known as lot 14 Block "L" on plat of G. P. MILLS and recorded in the RMC Office Greenville County, S. C., in Plat Book C at Page 176; and that the property lines, walls and buildings are as shown hereon, and that the walls and buildings located on said lot do not encroach or project on adjacent street or property, and that no adjacent walls or buildings encroach or project on said premises, and no power lines cross this property except as shown hereon.

R. B. Bruce

R. B. Bruce, R.M.C. 1952

CAROLINA SURVEYING
112 Manly St.
Greenville, S. C.

Recordable Plat

2 APR 30 85 1413

3:00CI

281/66A

219-7-17