


FILED
GREENVILLE CO. S.C.
MAY 1 11 01 AM '85
MAG. NORTH
DONNIE S. ANKERSLEY
R.M.C.

MAY 1 1985
32929
NIM-88

NOTE: 5' DRAINAGE & UTILITY
EASEMENT ALONG EACH
SIDE OF ALL SIDE &
REAR LOT LINES.

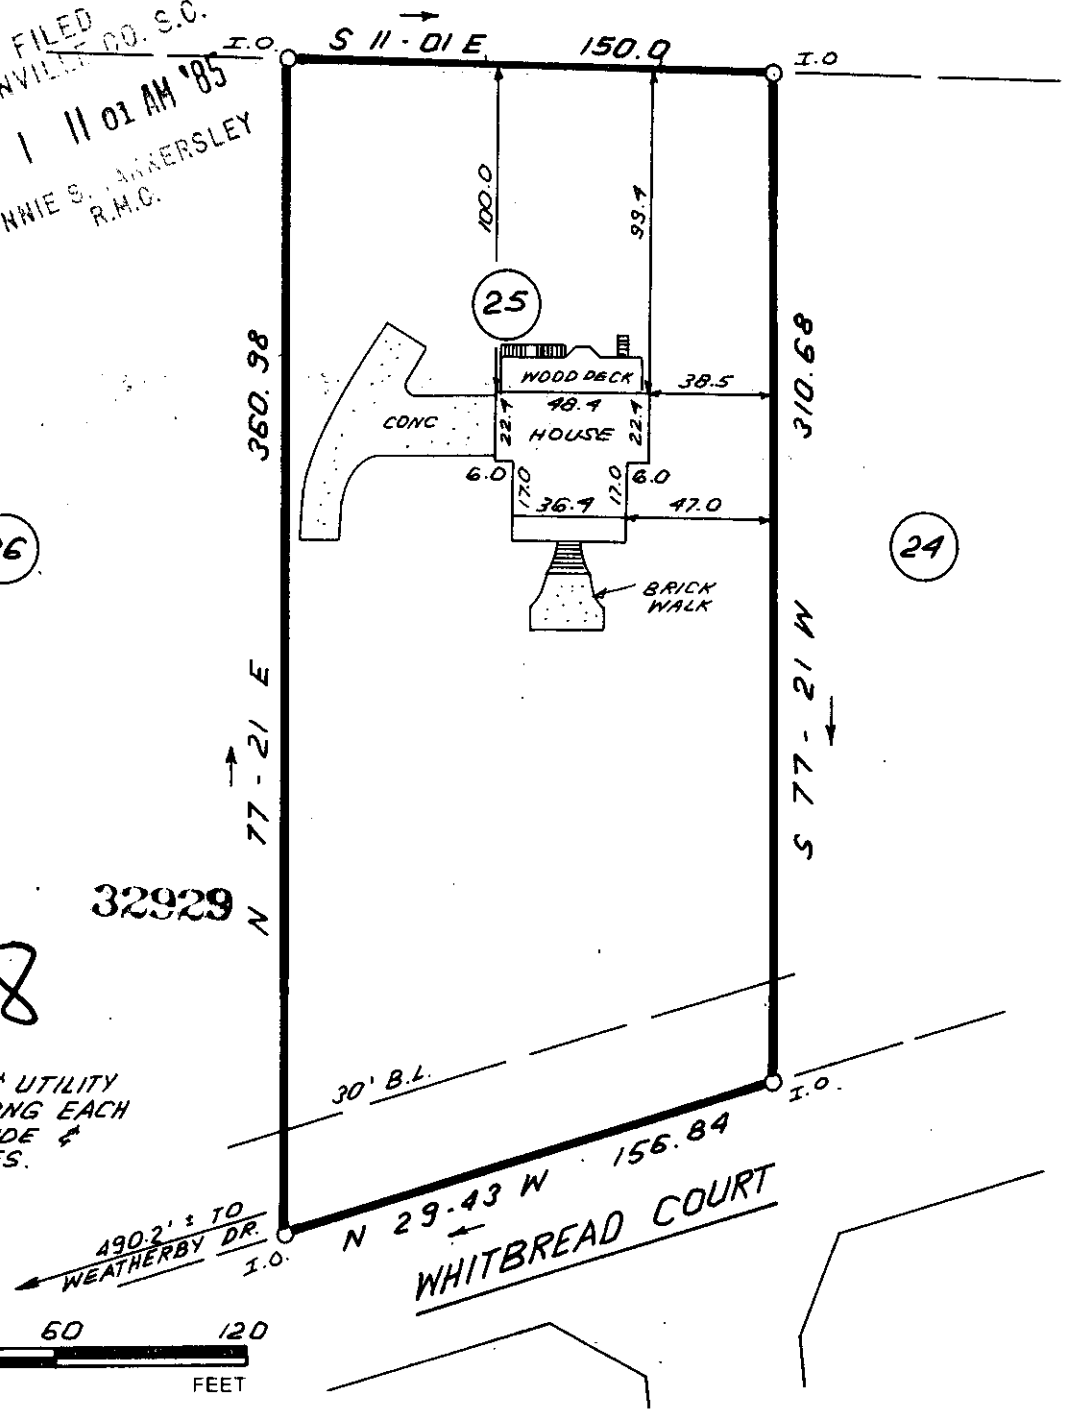

THIS IS TO CERTIFY THAT THE PROPERTY SHOWN ON THIS PLAT WAS SURVEYED UNDER MY DIRECT SUPERVISION. PROPERTY LINES AND IMPROVEMENTS SHOWN ARE LOCATED CORRECTLY AND THAT NO VISIBLE ENCROACHMENTS EXIST UNLESS OTHERWISE SHOWN. THIS PROPERTY IS NOT LOCATED IN A DESIGNATED FLOOD HAZARD AREA.

SOUTH CAROLINA
REGISTERED LAND SURVEYOR
4781
JAMES R. FREELAND
PLS: JAMES R. FREELAND
NO: 4781

STATE OF SOUTH CAROLINA
GREENVILLE COUNTY

CHAUNESSY
SHEET 2 OF 2, LOT 25
PROPERTY OF
FRANCIS E. CLARK
ANN B. CLARK

FREELAND & ASSOCIATES
Engineers • Land Surveyors
318 WEST STONE AVENUE.
GREENVILLE, S.C.
(803) 271-4924

PLAT BOOK
DEED BOOK
TAX MAP
PARTY CHIEF
DRAWN I.R.
DATE 4-17-85
DWG. NO. 11691