


FILED
 GREENVILLE CO. S.C.
 MAY 1 12 20 PM '85
 DONNIE S. HARRISLEY
 R.M.C.

Note: Improvements on this lot are not in a flood hazard area.

PROPERTY OF
 J. M. SMITH
 GREENVILLE COUNTY, GREENVILLE, S.C.
 SCALE: 1"=40' 26 APR 1985

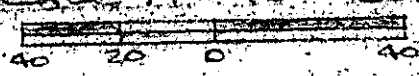

This is to certify that on the 26th day of April, 1985, I surveyed the property shown on this plat, being known as lots 31 & 33 on plat of HILLSIDE TERRACE and recorded in the RMC Office Greenville County, S. C., in Plat Book " F " at Page 154 and also known as PROPERTY OF J. M. SMITH and recorded in Plat Book at Page. ; and that the property lines, walls and buildings are as shown hereon, and that the walls and buildings located on said lot do not encroach or project on adjacent street or property, and that no adjacent walls or buildings encroach or project on said premises, and no power lines cross this property except as shown hereon.

MAY 1 1985

11-M-91 32932
 R. B. Bruce

R. B. Bruce, RLS # 1952

CAROLINA SURVEYING CO.
 112 Manly St.
 Greenville, S. C.

Recordable Plat

2 MYO1 35
 044

3.0001

11-4-647