


FILED
 GREENVILLE CO. S.C.
 MAY 22 8 33 AM '85
 DONNIE S. TANKERSLEY
 R.M.C.

NOTE: $\frac{1}{2}$ OF BRANCH IS ACTUAL REAR PROPERTY LINE,
 DRAINAGE EASEMENT 10' EACH SIDE OF BRANCH.
 SURVEY REFERENCES. PLAT BOOK BB-197
 D.V. 1140-150 & D.V. 1144-419
 P.34-1-33, 33.1 (Block & Nos.)

BAR SCALE

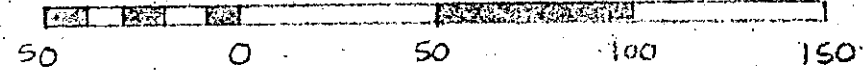


I CERTIFY THAT I HAVE SURVEYED THIS TRACT
 AND THAT IT IS, TO THE BEST OF MY KNOWLEDGE
 AS SHOWN; THAT THERE ARE NO ENCROACHMENTS;
 AND THAT THE LOTS ARE NOT IN A FLOOD HAZARD

MAY 22 1985

Hermit T. Gould
 HERMIT T. GOULD
 11 N-43 ✓ 35463

11 N-43

PROPERTY OF C. GORDON PATTERSON		
SCALE: 1" = 50'	APPROVED BY	DRAWN BY KAT
DATE: 5-14-85		
LOTS 3 AND 4, "AUDABON FOREST" SUBDIVISION GREENVILLE COUNTY, PARIS MOUNTAIN, SOUTH CAROLINA		
K.T. GOULD, INC.	TAYLORS, SC	DRAWING NUMBER

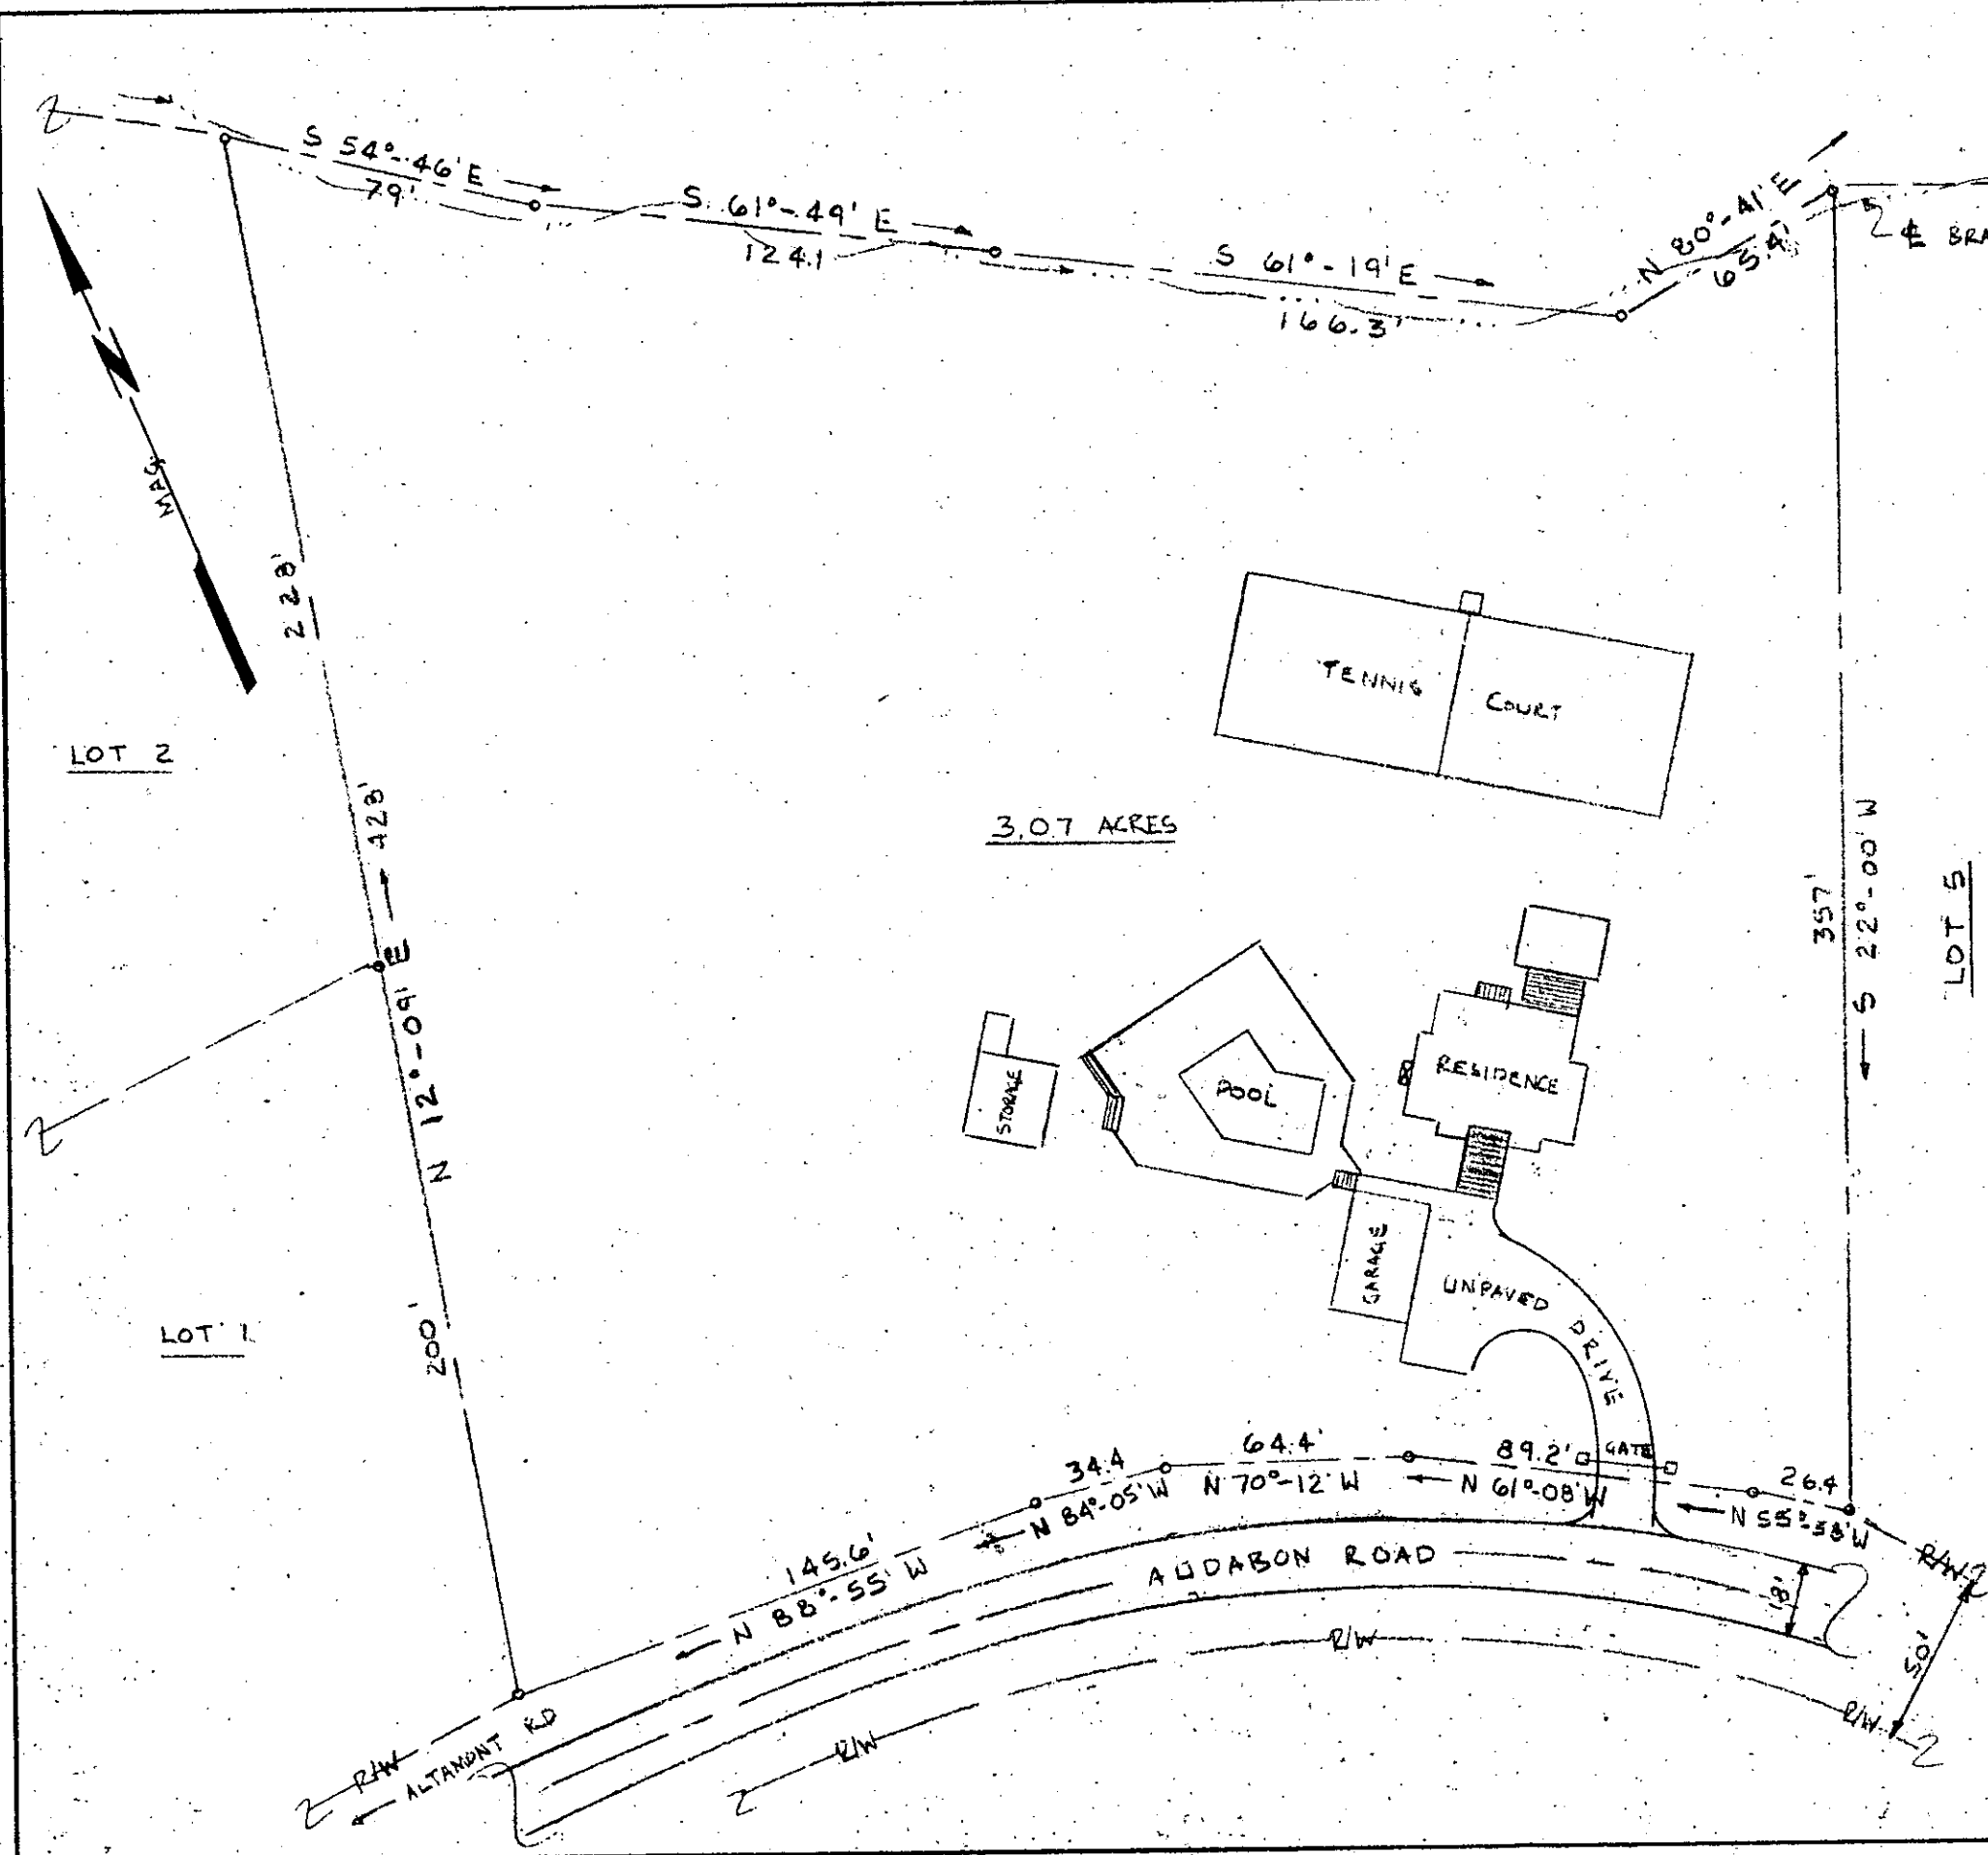

MICROFILMED