


MICROFILMED

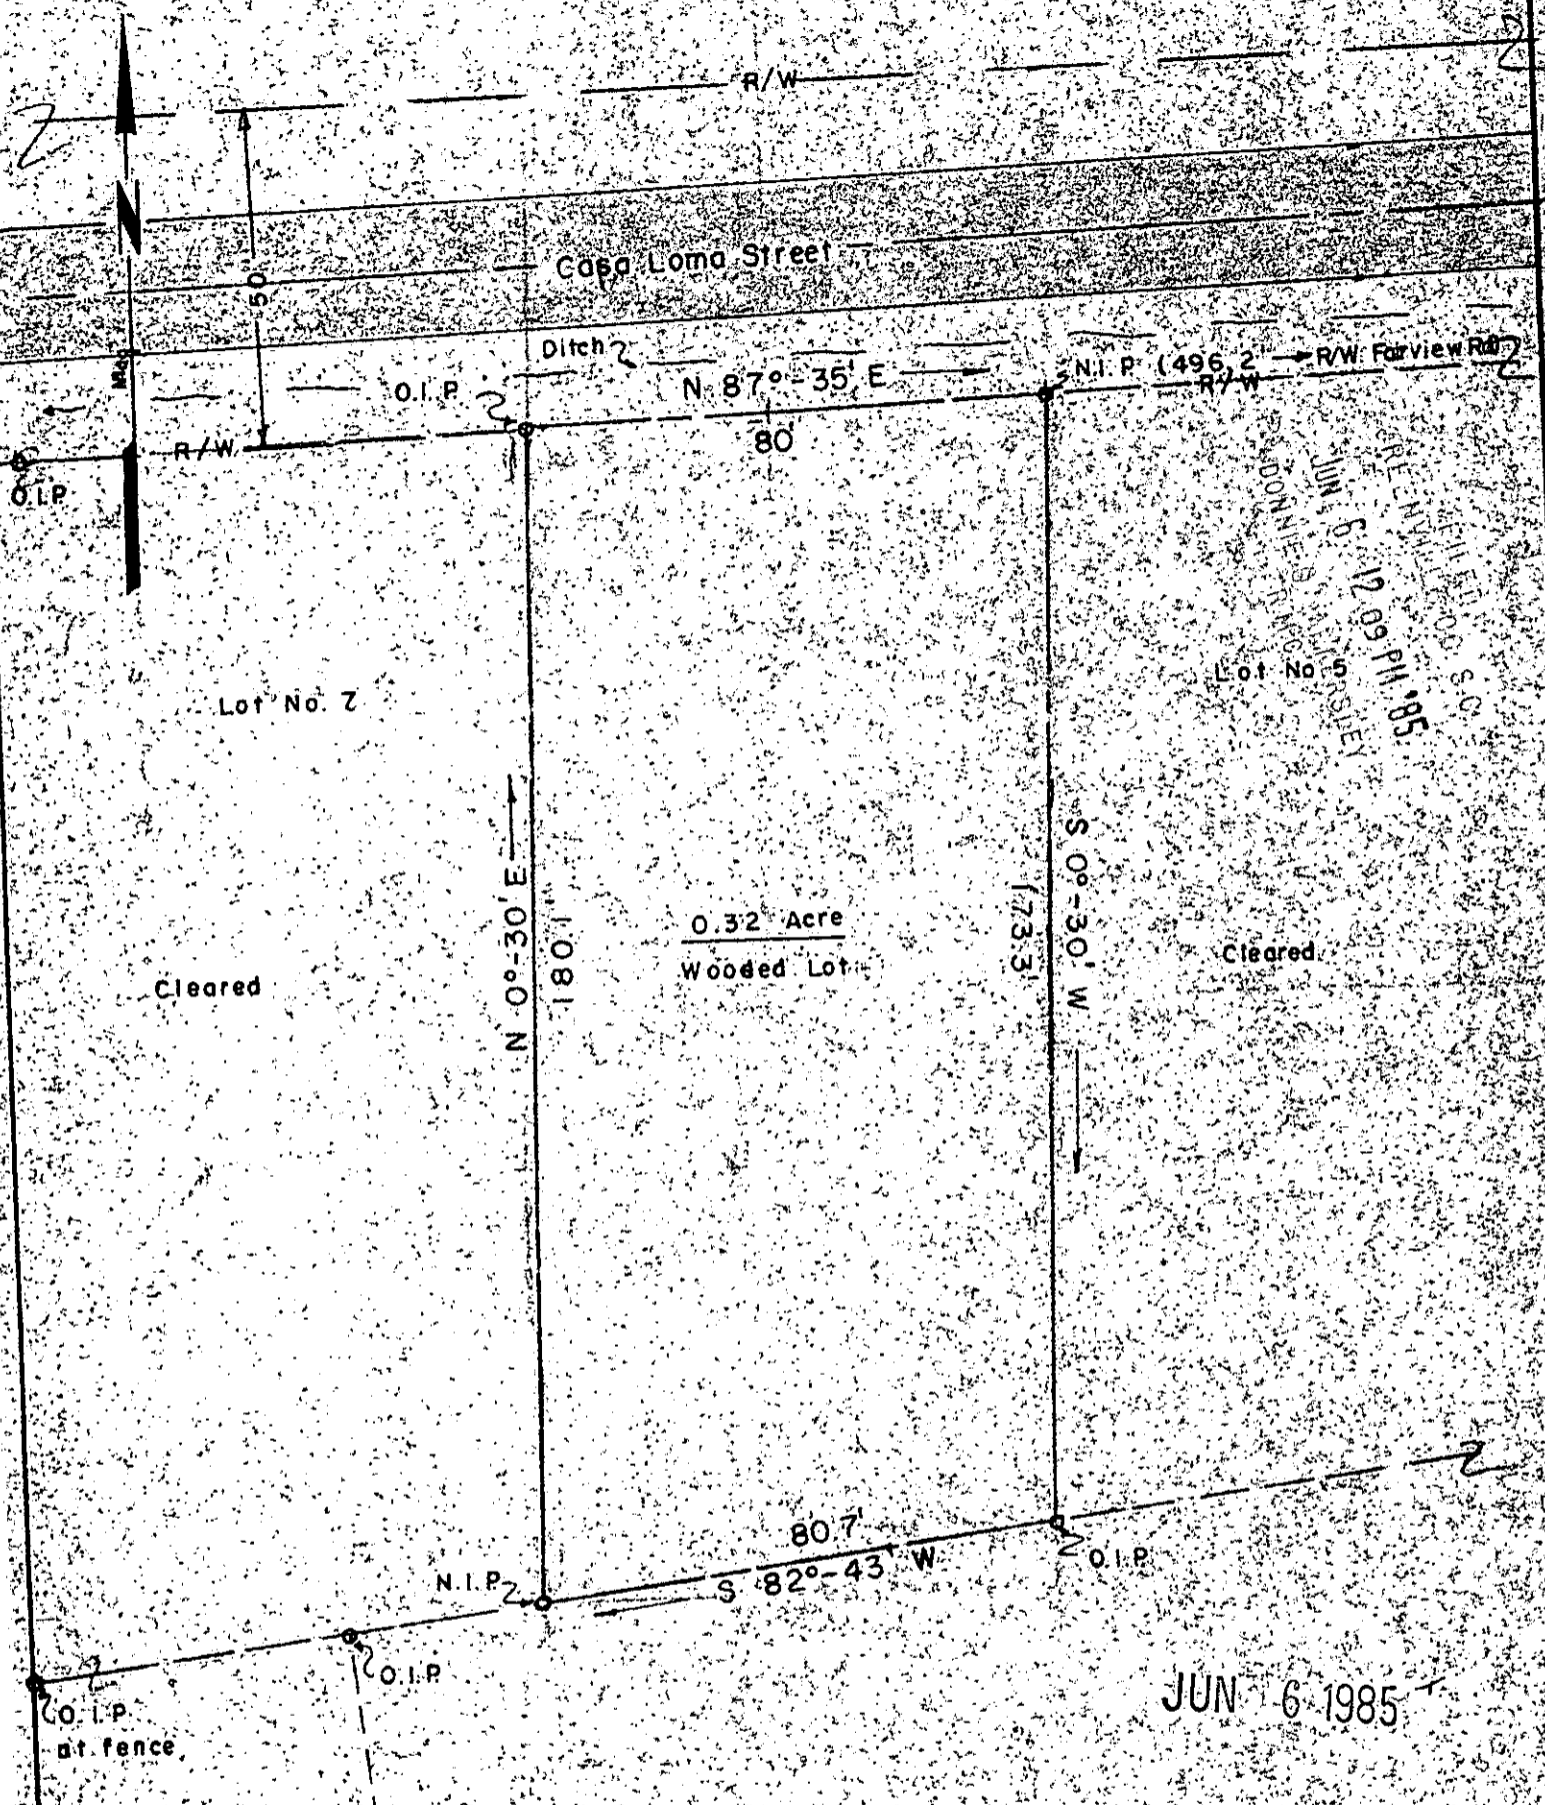

RECORDED  
 JUN 6 12 09 PM '85  
 GREENVILLE COUNTY S.C.  
 DONNIE B. WILSON  
 CLERK

JUN 6 1985

Reference plat prepared by W.N. Willis of Spartanburg, SC on March 25, 1960 (Original subdiv plat)  
 Water, power and sewer services available.

I certify that I have surveyed this lot and that it is, to the best of my knowledge, as shown,  
 that there are no encroachments, unless otherwise shown; and that, unless indicated above,  
 no portion of this lot lies within an officially designated flood plain.

11-N-72 37288

Seal	PROPERTY OF <b>James P. Mulligan</b>	Date 2-5-85
		Scale 1" = 30'
	Lot No. 6, "Laurel Hills" Subdivision Greenville County, Taylors, South Carolina	Dwg. No.
		Dwn. By KGjr
	K. T. GOULD, INC 3228-A Wade Hampton Blvd Taylors, SC	Survey References Block Sheet
		Plat Bk Deed Vol.