

Note:  
Improvements on this lot are not in a flood hazard area.


Note:  
3' drainage & utility easement each side all side & rear lot lines unless otherwise shown.

AGEWOOD COUNTY  
WATER & SEWER IN ST NW

PROPERTY OF

JOHN G. JENKINS, SR. & MARY A. JENKINS

SIMPSONVILLE, S.C.  
SCALE: 1"=40' 23 APR 1985

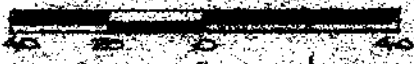

This is to certify that on the 23rd day of April, 1985, I surveyed the property shown on this plat, being known as lot 525 on plat of SHEET NO. TWO WESTWOOD SECTION V and recorded in the REC Office Greenville County, S. C., in Plat Book "4 - X" at Page 63; and that the property lines, walls and buildings are as shown hereon, and that the walls and buildings located on said lot do not encroach or project on adjacent street or property, and that no adjacent walls or buildings encroach or project on said premises, and no power lines cross this property except as shown hereon.

33469 11-0.15

*R. B. Bouch*  
R. B. Bouch, RLS #1952

CAROLINA SURVEYING CO.  
112 Mainly St.  
Greenville, S. C.

Recordable Plat