MICROFILMED

FILED
GREENVILLE CO. S.C.
MAY 6 3 10 PM '85
DONNIE S. TANKERSLEY
R.M.C.

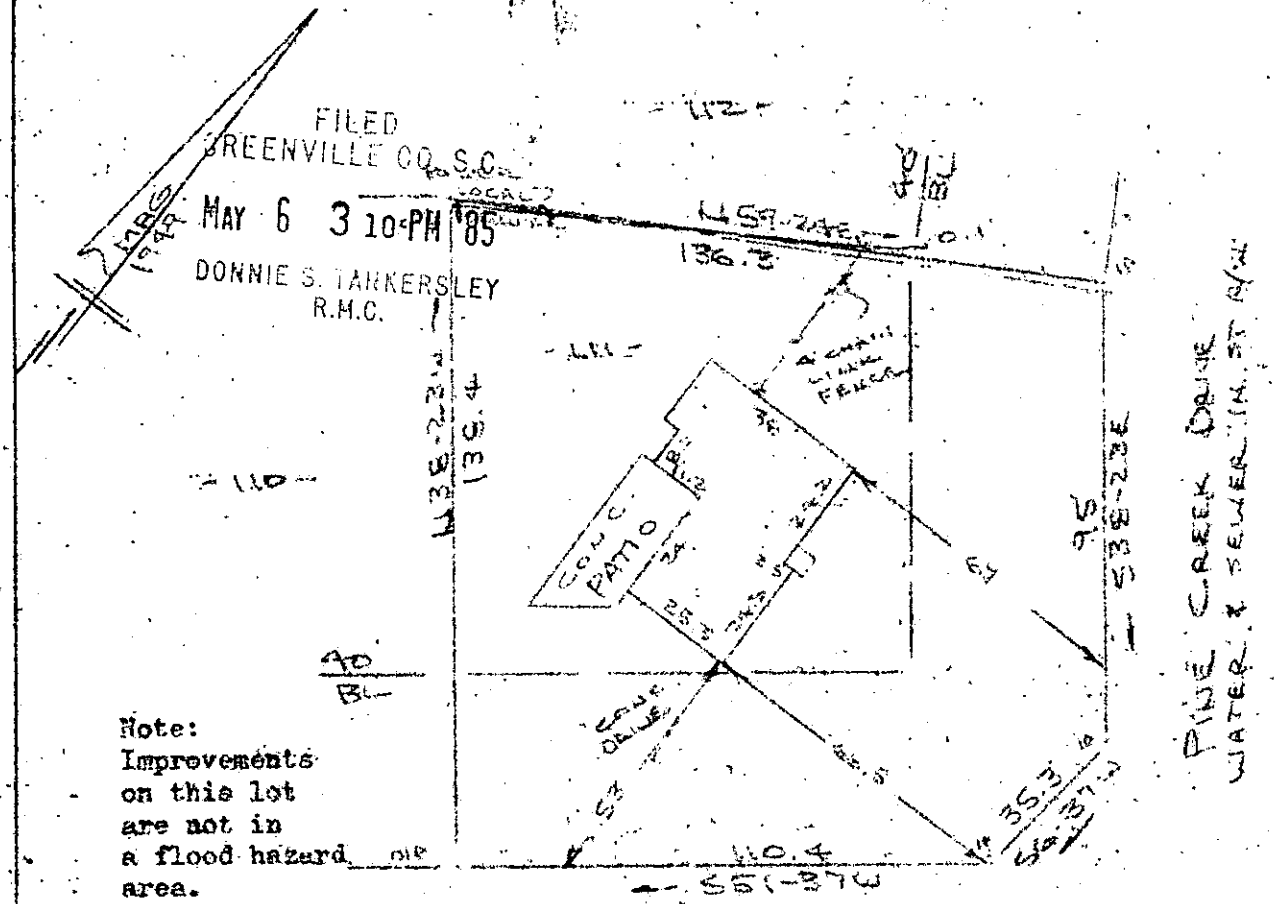

Note:
Improvements on this lot are not in a flood hazard area.

CRESTFIELD ROAD

PROPERTY OF
HUGH TALLENT, JR. & LEANORE I. TALLENT
NEAR GREENVILLE, S.C.
SCALE 1"=40' 2 MAY 1985

40 20 0 40

This is to certify that on the 2nd day of May, 1985, I surveyed the property shown on this plat, being known as lot 111 on plat of WOODFIELDS and recorded in the RMC Office Greenville County, S. C., in Plat Book " W " at Page 49; and that the property lines, walls and buildings are as shown hereon, and that the walls and buildings located on said lot do not encroach or project on adjacent street or property, and that no adjacent walls or buildings encroach orproject on said premises, and no power lines cross this property except as shown hereon.

33504

11-0-17

MAY 6 1985

R. B. Bruce

R. B. Bruce, RLS # 1952

CAROLINA SURVEYING CO.
112 Manly St.
Greenville, S. C.

R B Bruce
SOUTH CAROLINA
REGISTERED
LAND SURVEYOR

Recordable Plat

MAY 06 85

319

3.00CT

286/40

369-8-1