


ENGRAVED

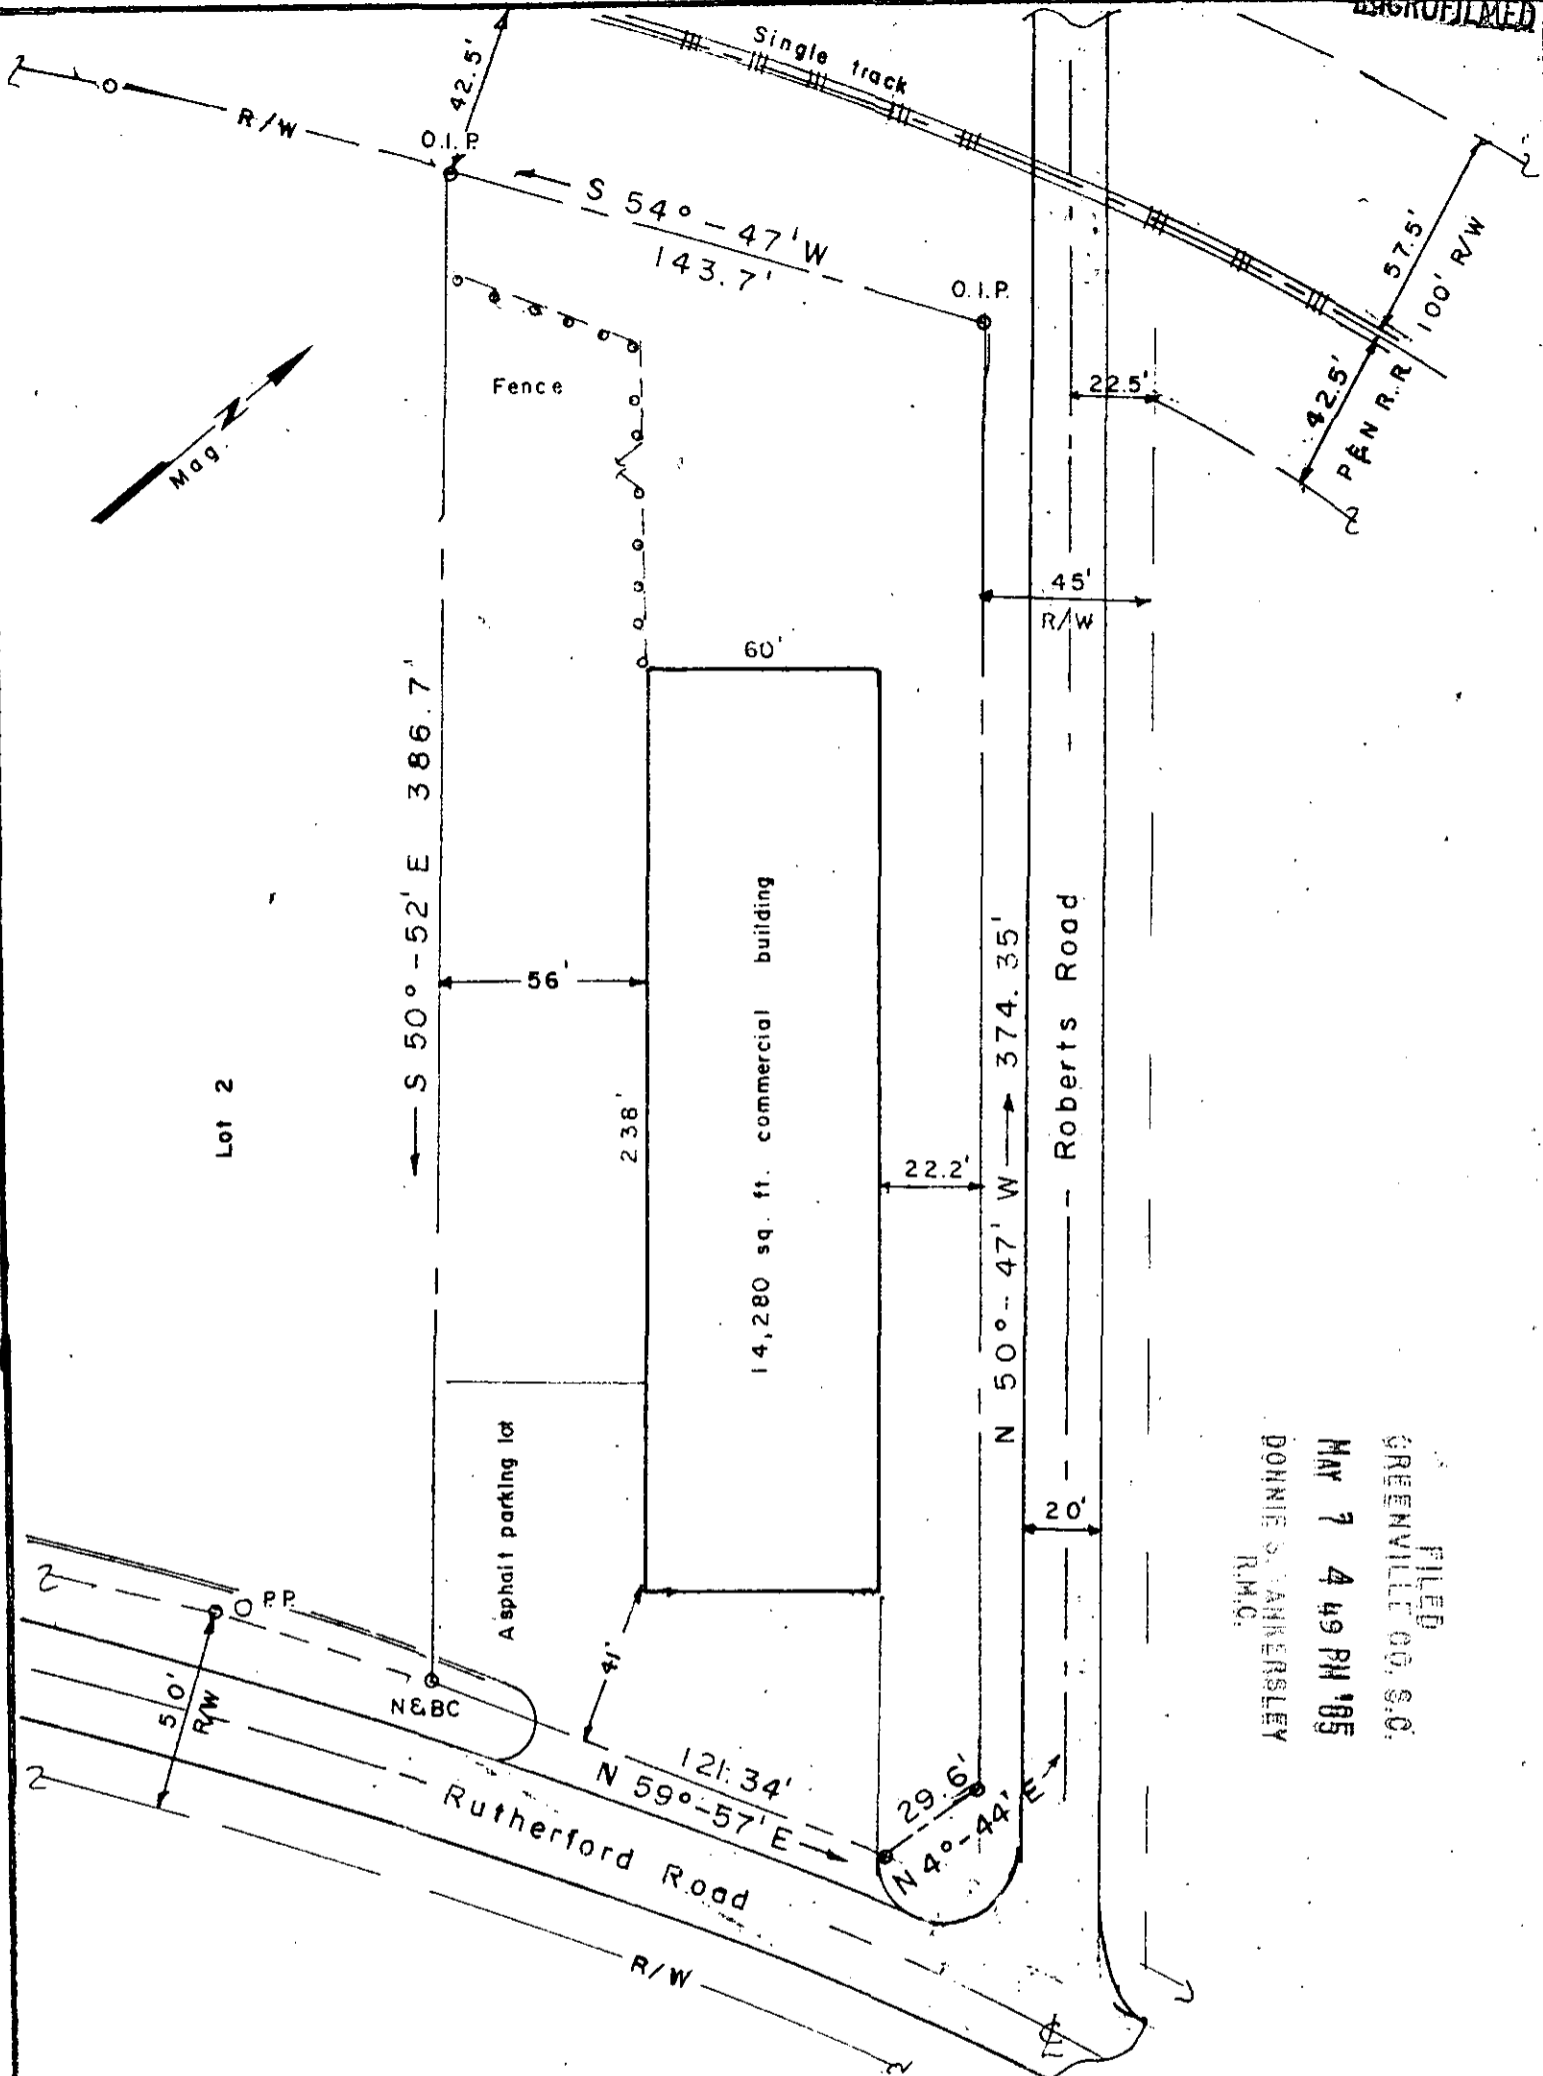

FILED
 GREENVILLE CO. S.C.
 MAY 7 4 49 PM '85
 DOHNIE S. ANKERLEY
 R.M.C.

I certify that I have surveyed this lot and that it is, to the best of my knowledge, as shown above; that there are no encroachments; and that the lot is not in a flood plain.

11-0-24 33701

Seal 	PROPERTY OF Wesley L. Neely	Date: 4-30-85 Scale: 1" = 50' Dwn. By: KG jr
	1.24 Acre Lot Greenville County Chick Springs Twp. Taylors, SC K.T. GOULD, INC 3228 A Wade Hampton Blvd. Taylors, SC 8	Lot 3 of a 3.97 acre tract formerly property of Neely's, Inc, divided 10-Z-7-75. Block Bk. Ref. P21-2 11801