

62

60

61


FILED  
 GREENVILLE CO. S.C.  
 MAY 9 4 42 PM '85  
 DONNIE S. WALKERSLEY  
 R.M.C.

MEREDITH LANE

MAY 9 1985

11-0-33 34031

NOTE: 5' DRAINAGE AND/OR  
 UTILITY EASEMENT ALONG  
 ALL SIDE & REAR LOT LINES.

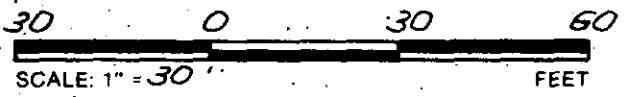

THIS IS TO CERTIFY THAT THE PROPERTY SHOWN ON THIS PLAT WAS SURVEYED UNDER MY DIRECT SUPERVISION. PROPERTY LINES AND IMPROVEMENTS SHOWN ARE LOCATED CORRECTLY AND THAT NO VISIBLE ENCROACHMENTS EXIST UNLESS OTHERWISE SHOWN. THIS PROPERTY IS NOT LOCATED IN A DESIGNATED FLOOD HAZARD AREA.

**STATE OF SOUTH CAROLINA**  
**GREENVILLE COUNTY**

**FREELAND & ASSOCIATES**  
 Engineers • Land Surveyors  
 318 WEST STONE AVENUE.  
 GREENVILLE, S.C.  
 (803) 271-4924

HENDERSON FOREST  
LOT 61  
PROPERTY OF  
WILLIAM R. QUEEN  
MARY L. QUEEN

PLAT BOOK	4R@ 41
DEED BOOK	
TAX MAP	
PARTY CHIEF	J.C.C.
DRAWN	K.E.G.
DATE	3-19-85
DWG. NO.	12640

SOUTH CAROLINA  
 REGISTERED LAND SURVEYOR  
 4781  
 JAMES R. FREELAND  
 SLS: JAMES R. FREELAND  
 NO: 4781