

RECORDED

FILED
GREENVILLE CO. S.C.
MAY 13 10 49 AM '85
DONNIE S. JANKERSLEY
R.M.C.



189


188

187

138

139


140

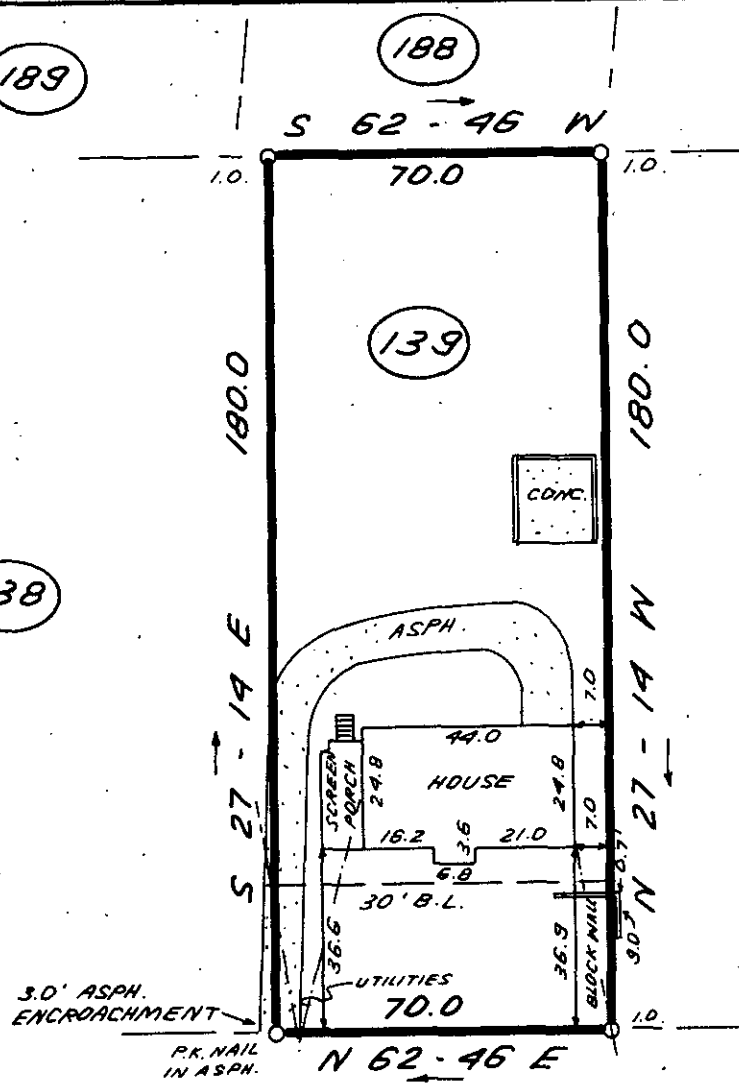

LADY MARIAN LANE


34390

11-0-39

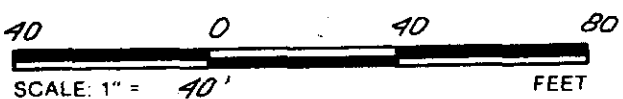

MAY 13 1985

THIS IS TO CERTIFY THAT THE PROPERTY SHOWN ON THIS PLAT WAS SURVEYED UNDER MY DIRECT SUPERVISION. PROPERTY LINES AND IMPROVEMENTS SHOWN ARE LOCATED CORRECTLY AND THAT NO VISIBLE ENCROACHMENTS EXIST UNLESS OTHERWISE SHOWN. THIS PROPERTY IS NOT LOCATED IN A DESIGNATED FLOOD HAZARD AREA.

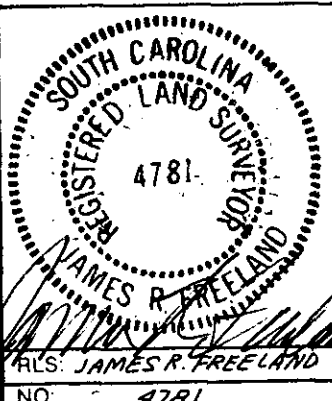

STATE OF SOUTH CAROLINA
GREENVILLE COUNTY

FREELAND & ASSOCIATES
Engineers • Land Surveyors
318 WEST STONE AVENUE.
GREENVILLE, S.C.
(803) 271-4924

SHERWOOD FOREST
LOT 139
PROPERTY OF
RANDALL E. HERBIG

PLAT BOOK	660 283
DEED BOOK	1053-295
TAX MAP	589-267-1-73
PARTY CHIEF	L.T.
DRAWN	K.E.G.
DATE	4-29-85
DWG. NO.	129/5

2 MY 13 85 905 3.00CI