MICROFILMED

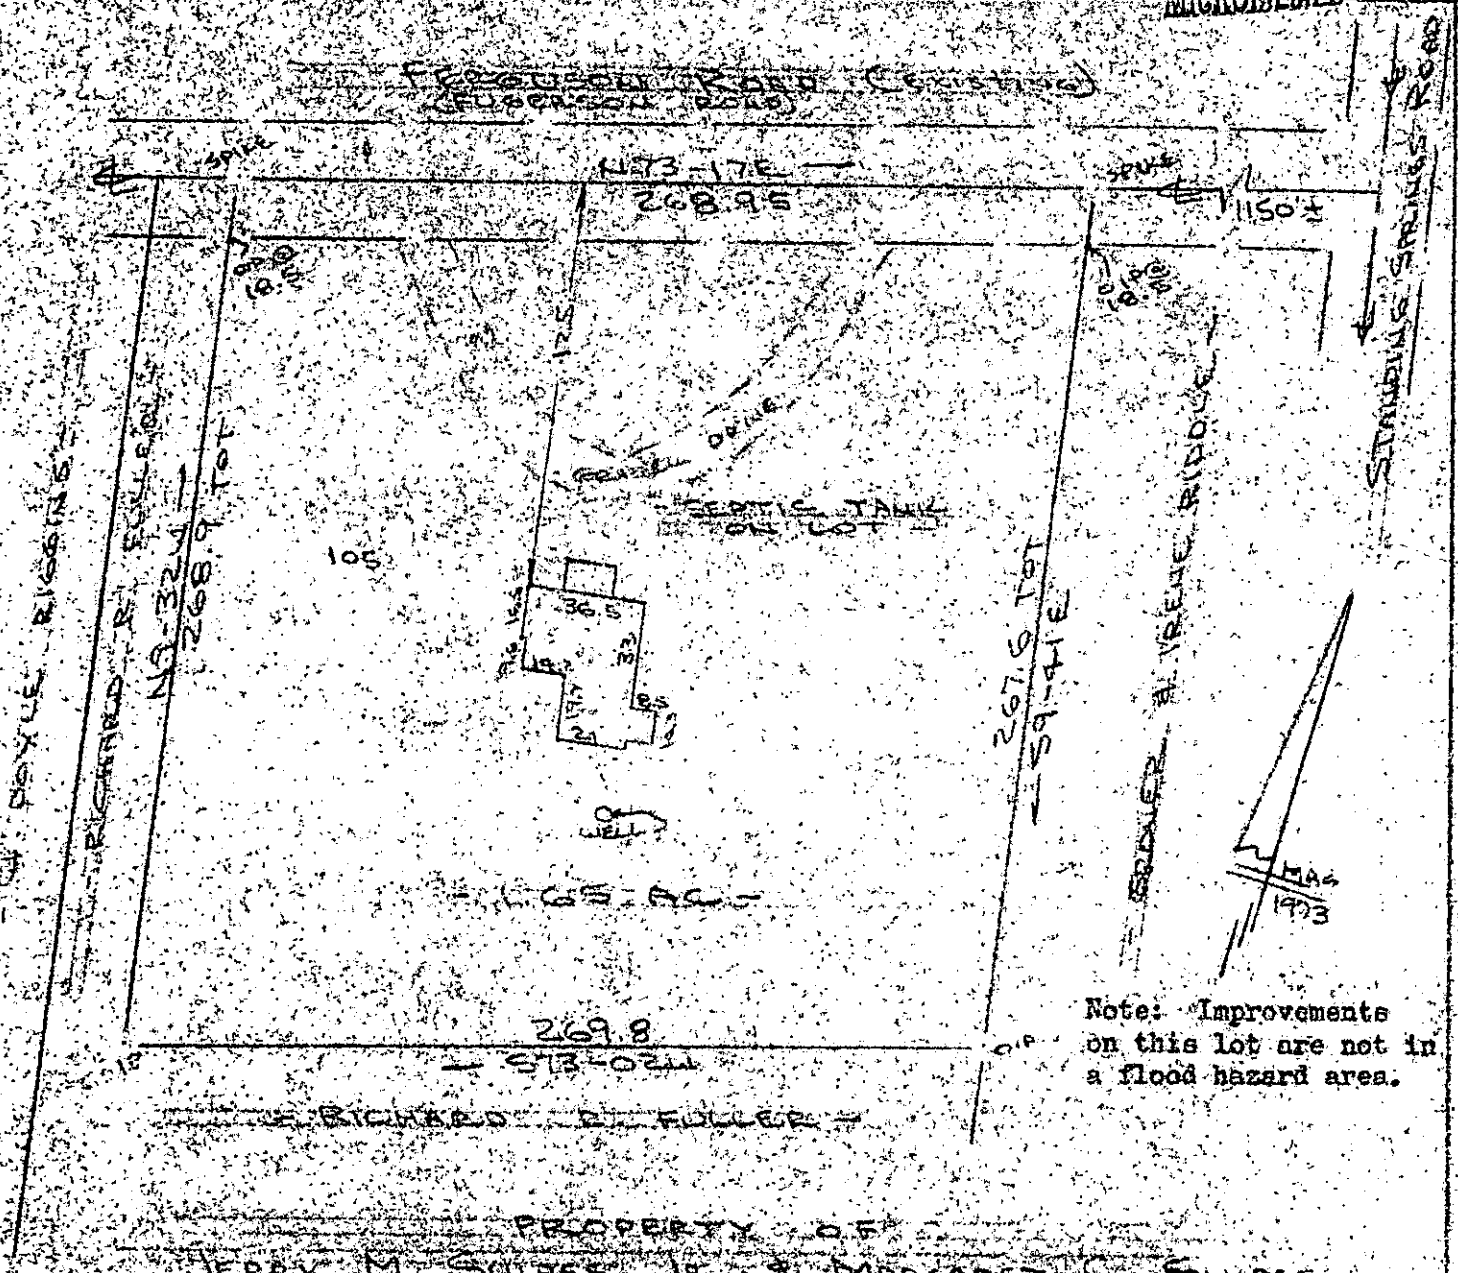

This is to certify that on the 6th day of May, 1985, I surveyed the property shown on this plat, boing known as 1.65 acres on plat of RALPH JAMES HILL and recorded in the RMC Office Greenville County, S. C., in Plat Book 4 - O at Page 323; and that the property lines, walls and buildings are as shown hereon, ad that the walls and buildings located on said lot do not encroach or project on adjacent street or property, and that no adjacent walls or buildings encroach or project on said premises, and no power lines cross this property except as shown hereon. Also known as PROPERTY OF JERRY M. SNIPES, JR. & MARGARET C. SNIPES and recorded in Plat Book at Page

34387

11-0-42

R. B. Bruce

R. B. Bruce, RLS # 1952

CAROLINA SURVEYING CO.
112 Manly St.
Greenville, S. C.

Recordable Plat

FILED
GREENVILLE CO. S. C.
MAY 13 12 17 PM '85
DONNIE S. TANKERSLEY
R.M.C.