


FILED
GREENVILLE CO. S.C.

MAY 13 2 32 PM '85

DONNIE S. TARKERSLEY
R.M.C.

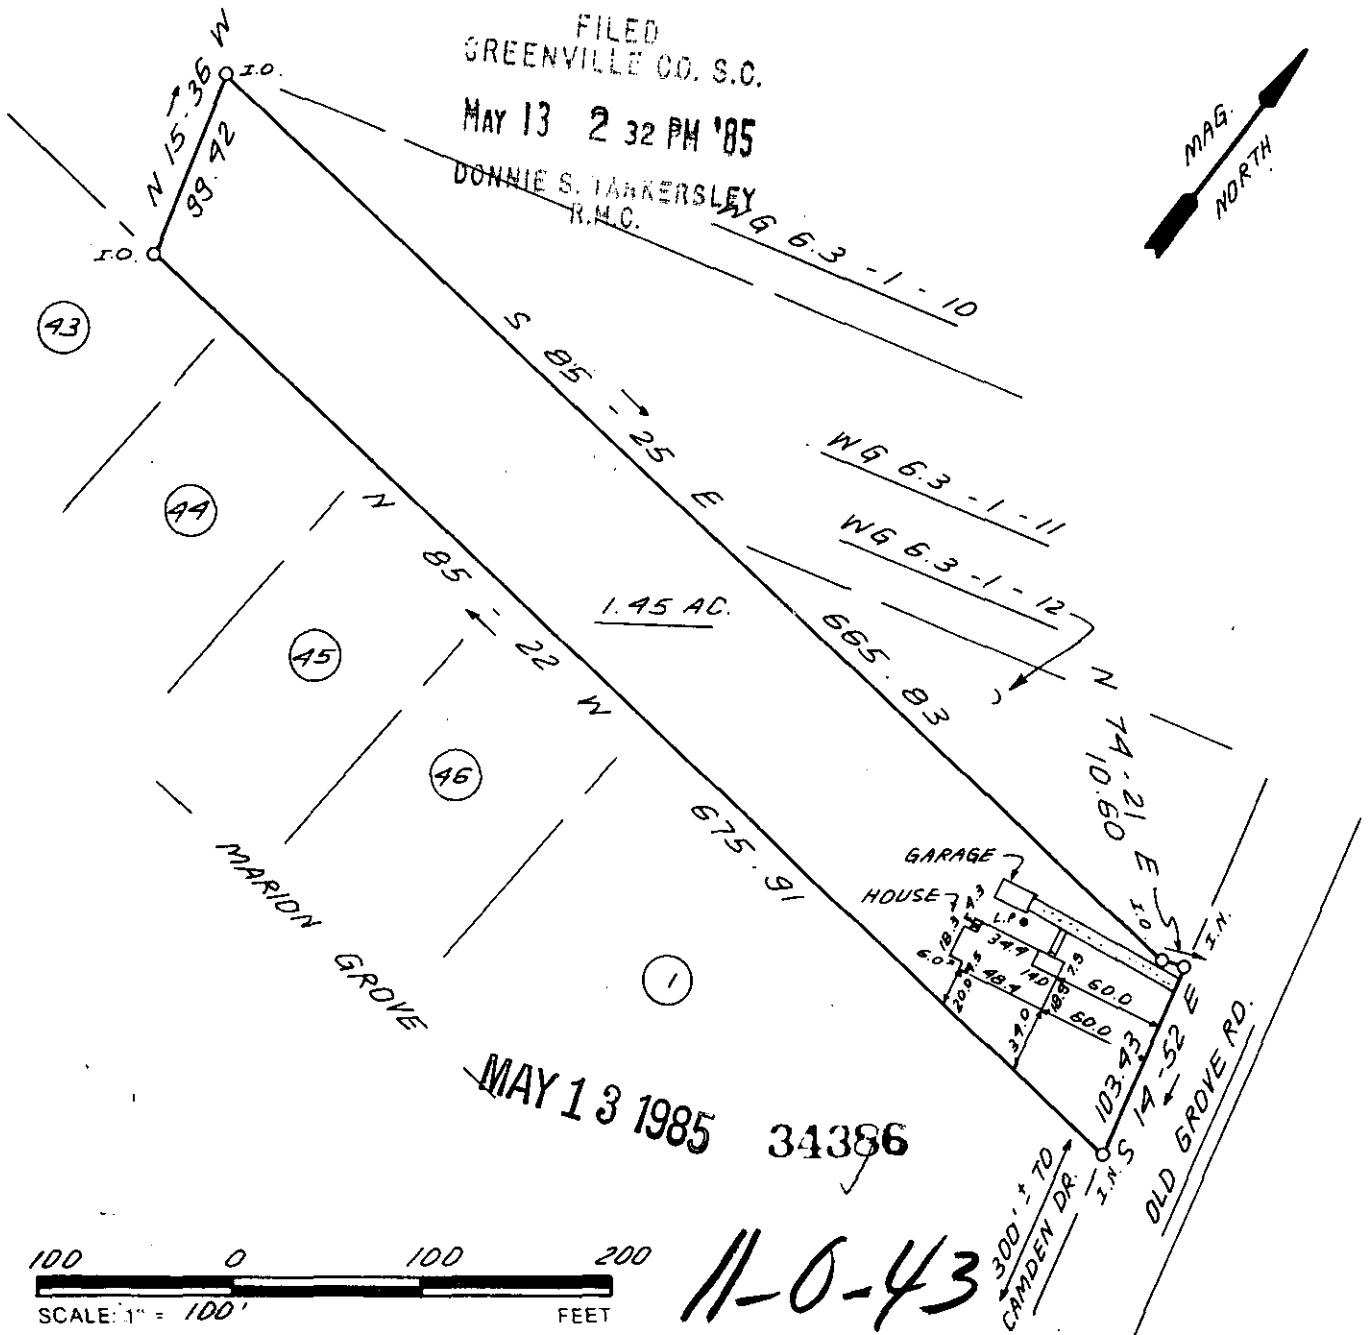

MAY 13 1985 34386

11-0-43

100 0 100 200
SCALE: 1" = 100' FEET

THIS IS TO CERTIFY THAT THE PROPERTY SHOWN ON THIS PLAT WAS SURVEYED UNDER MY DIRECT SUPERVISION PROPERTY LINES AND IMPROVEMENTS SHOWN ARE LOCATED CORRECTLY AND THAT NO VISIBLE ENCROACHMENTS EXIST UNLESS OTHERWISE SHOWN. THIS PROPERTY IS NOT LOCATED IN A DESIGNATED FLOOD HAZARD AREA

SOUTH CAROLINA
REGISTERED LAND SURVEYOR
JAMES R. FREELAND

RLS JAMES R. FREELAND
NO: 4781

STATE OF SOUTH CAROLINA
GREENVILLE COUNTY

SURVEY FOR
T. MICHAEL SHOEMAKER
PATTI K. SHOEMAKER

GCTO -----3 MY13 85

FREELAND & ASSOCIATES
Engineers • Land Surveyors
318 WEST STONE AVENUE.
GREENVILLE, S.C.
(803) 271-4924

PLAT BOOK
DEED BOOK 1045 - 426
TAX MAP WG 6.3 - 1.13
PARTY CHIEF J.E.C.
DRAWN K.E.G.
DATE 5-9-85
DWG NO. 12978