


FILED
GREENVILLE CO. S.C.

MAY 15 8 42 AM '85

DONNIE S. JANNERS
R.M.C.

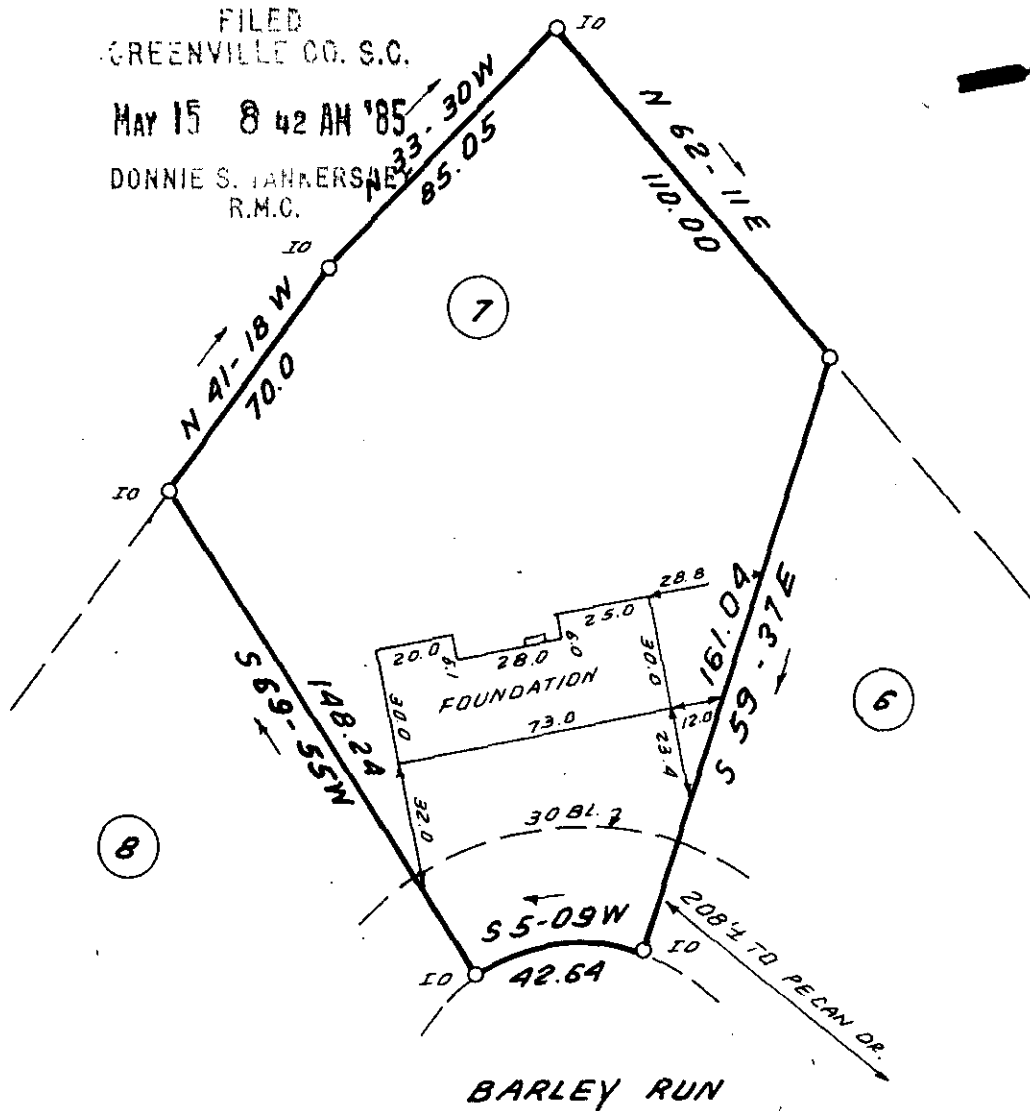

MAY 15 1985


34633

NOTE: 5' DRAINAGE & UTILITY EASEMENT ALONG EACH SIDE OF ALL SIDE & REAR LOT LINES.



11-0-46

THIS IS TO CERTIFY THAT THE PROPERTY SHOWN ON THIS PLAT WAS SURVEYED UNDER MY DIRECT SUPERVISION. PROPERTY LINES AND IMPROVEMENTS SHOWN ARE LOCATED CORRECTLY AND THAT NO VISIBLE ENCROACHMENTS EXIST UNLESS OTHERWISE SHOWN. THIS PROPERTY IS NOT LOCATED IN A DESIGNATED FLOOD HAZARD AREA.

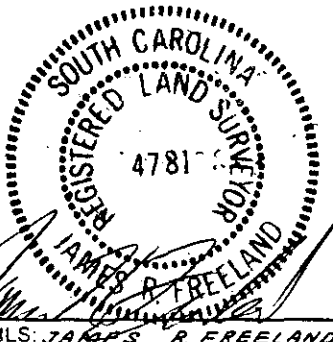

**STATE OF SOUTH CAROLINA
GREENVILLE COUNTY**

GILDER CREEK ESTATES
PHASE ONE; LOT 7
PROPERTY OF
LOREN D. HIGGINS
PATRICIA A. HIGGINS

FREELAND & ASSOCIATES
Engineers • Land Surveyors
318 WEST STONE AVENUE.
GREENVILLE, S.C.
(803) 271-4924

PLAT BOOK	9 W 58
DEED BOOK	
TAX MAP	
PARTY CHIEF	RAJ
DRAWN	B.R.
DATE	4-8-85
DWG. NO.	12,766