MICROFILMED

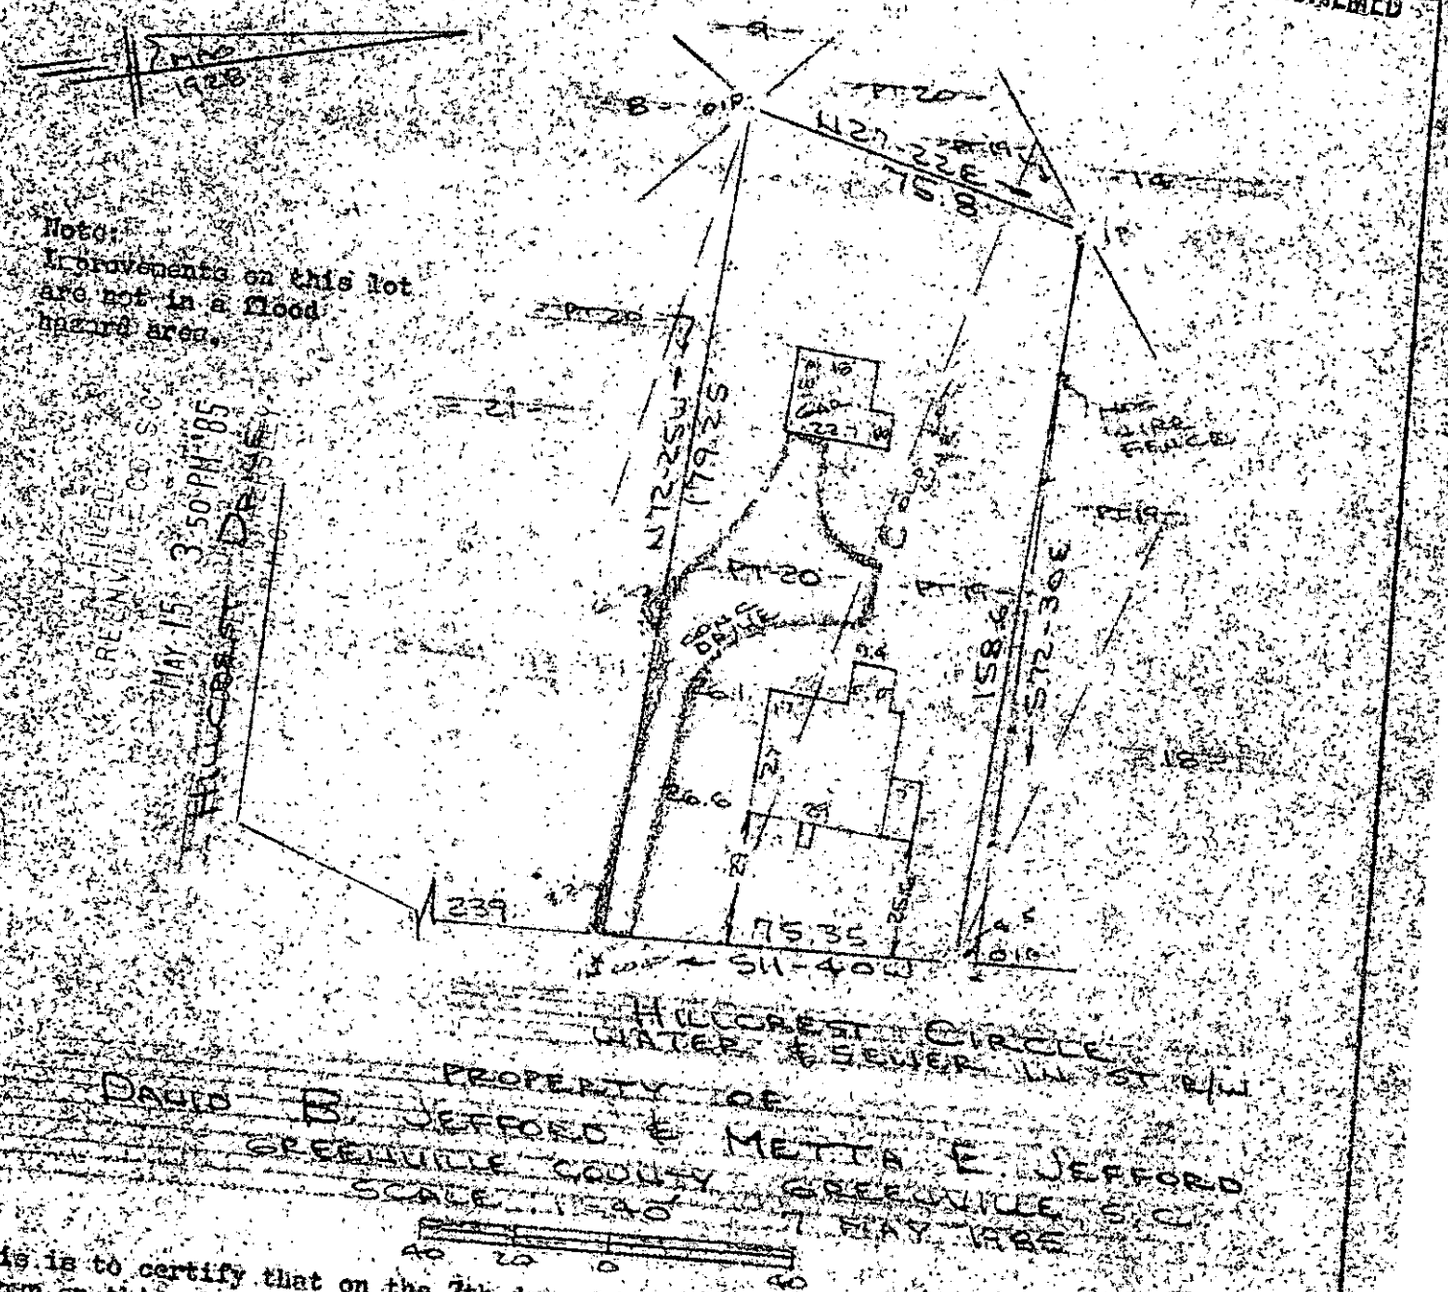

This is to certify that on the 7th day of May, 1985, I surveyed the property shown on this plat, being known as part of lot 19 and part of lot 20 on plat of HILLCREST CIRCLE and recorded in the RMC Office Greenville County, S. C., in Plat Book " Q " at Page 3 and also known as PROPERTY OF DAVID B. JEFFORD & METTA E. JEFFORD and recorded in the Plat Book at Page ; and that the property lines, walls and buildings are as shown hereon, and that the walls and buildings located on said lot do not encroach or project on adjacent street or project on said premises, and no power lines cross this property except as shown hereon.

34632

11-0-51

MAY 15 1985

MAY 15 1985

R. B. Bruce

R. B. Bruce, RLS # 1982

CAROLINA SURVEYING CO.
112 Manly St.
Greenville, S.

Recordable Plat

3 MAY 15 85 066

3.00

285/62

187-3-3.1