


FILED
GREENVILLE CO. S.C.
MAY 20 2 36 PM '85
DONNIE S. JACKSON
R.M.C.

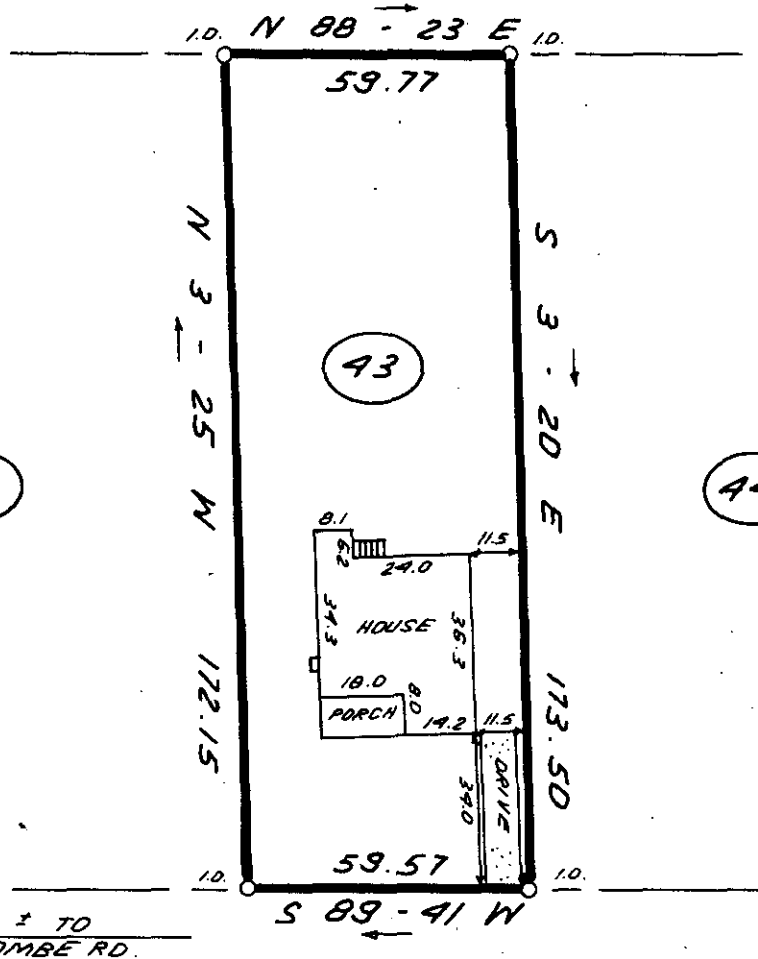

NORTH HAVEN DRIVE

MAY 20 1985

35167

11-0-64



THIS IS TO CERTIFY THAT THE PROPERTY SHOWN ON THIS PLAT WAS SURVEYED UNDER MY DIRECT SUPERVISION. PROPERTY LINES AND IMPROVEMENTS SHOWN ARE LOCATED CORRECTLY AND THAT NO VISIBLE ENCROACHMENTS EXIST UNLESS OTHERWISE SHOWN. THIS PROPERTY IS NOT LOCATED IN A DESIGNATED FLOOD HAZARD AREA.

**STATE OF SOUTH CAROLINA
GREENVILLE COUNTY**

FREELAND & ASSOCIATES
Engineers • Land Surveyors
318 WEST STONE AVENUE.
GREENVILLE, S.C.
(803) 271-4924

BUNCOMBE PARK
LOT 43
PROPERTY OF
BRETT A. MARTIN
DIANNA T. MARTIN

PLAT BOOK	MB 12
DEED BOOK	1161 - 962
TAX MAP	
PARTY CHIEF	J.C.C.
DRAWN	K.E.G.
DATE	4 - 29 - 85
DWG. NO.	12911

