

FILED
GREENVILLE CO. S.C.

MAY 29 1 57 PM '85




MANNIE S. TARRERSLEY
R.M.C.

387

388

394

392

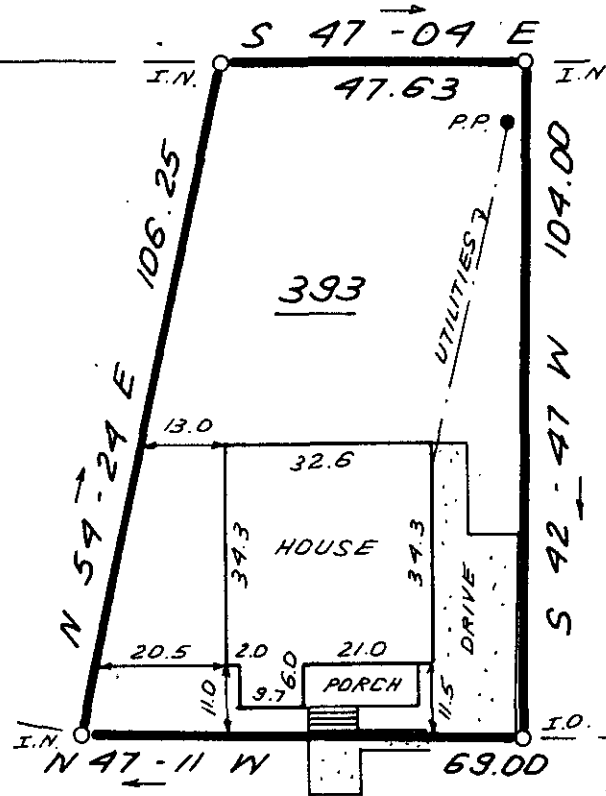

MAY 29 1985

MCARTHUR ST.


295' ± TO
DORSEY BLVD.

36130



11-0-98

THIS IS TO CERTIFY THAT THE PROPERTY SHOWN ON THIS PLAT WAS SURVEYED UNDER MY DIRECT SUPERVISION. PROPERTY LINES AND IMPROVEMENTS SHOWN ARE LOCATED CORRECTLY AND THAT NO VISIBLE ENCROACHMENTS EXIST UNLESS OTHERWISE SHOWN. THIS PROPERTY IS NOT LOCATED IN A DESIGNATED FLOOD HAZARD AREA.

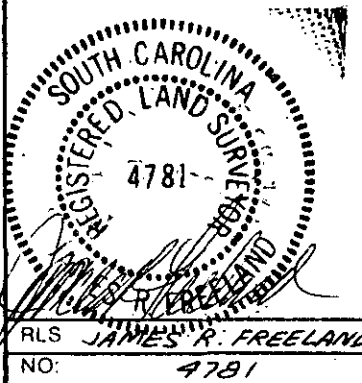

**STATE OF SOUTH CAROLINA
GREENVILLE COUNTY**

ABNEY MILLS
SEC 2, LOT 393
PROPERTY OF
GEORGE E. KELLETT, JR.
NANCY J. KELLETT

FREELAND & ASSOCIATES
Engineers • Land Surveyors
318 WEST STONE AVENUE.
GREENVILLE, S.C.
(803) 271-4924

PLAT BOOK	QQ@ 56 & 59
DEED BOOK	1158 - 215
TAX MAP	118 - 9 - 11
PARTY CHIEF	J.C.C.
DRAWN	K.E.G.
DATE	5-24-85
DWG NO	13052

2 MAY 29 1985 714

3.0001