


LOCATION MAP

MICROFILMED

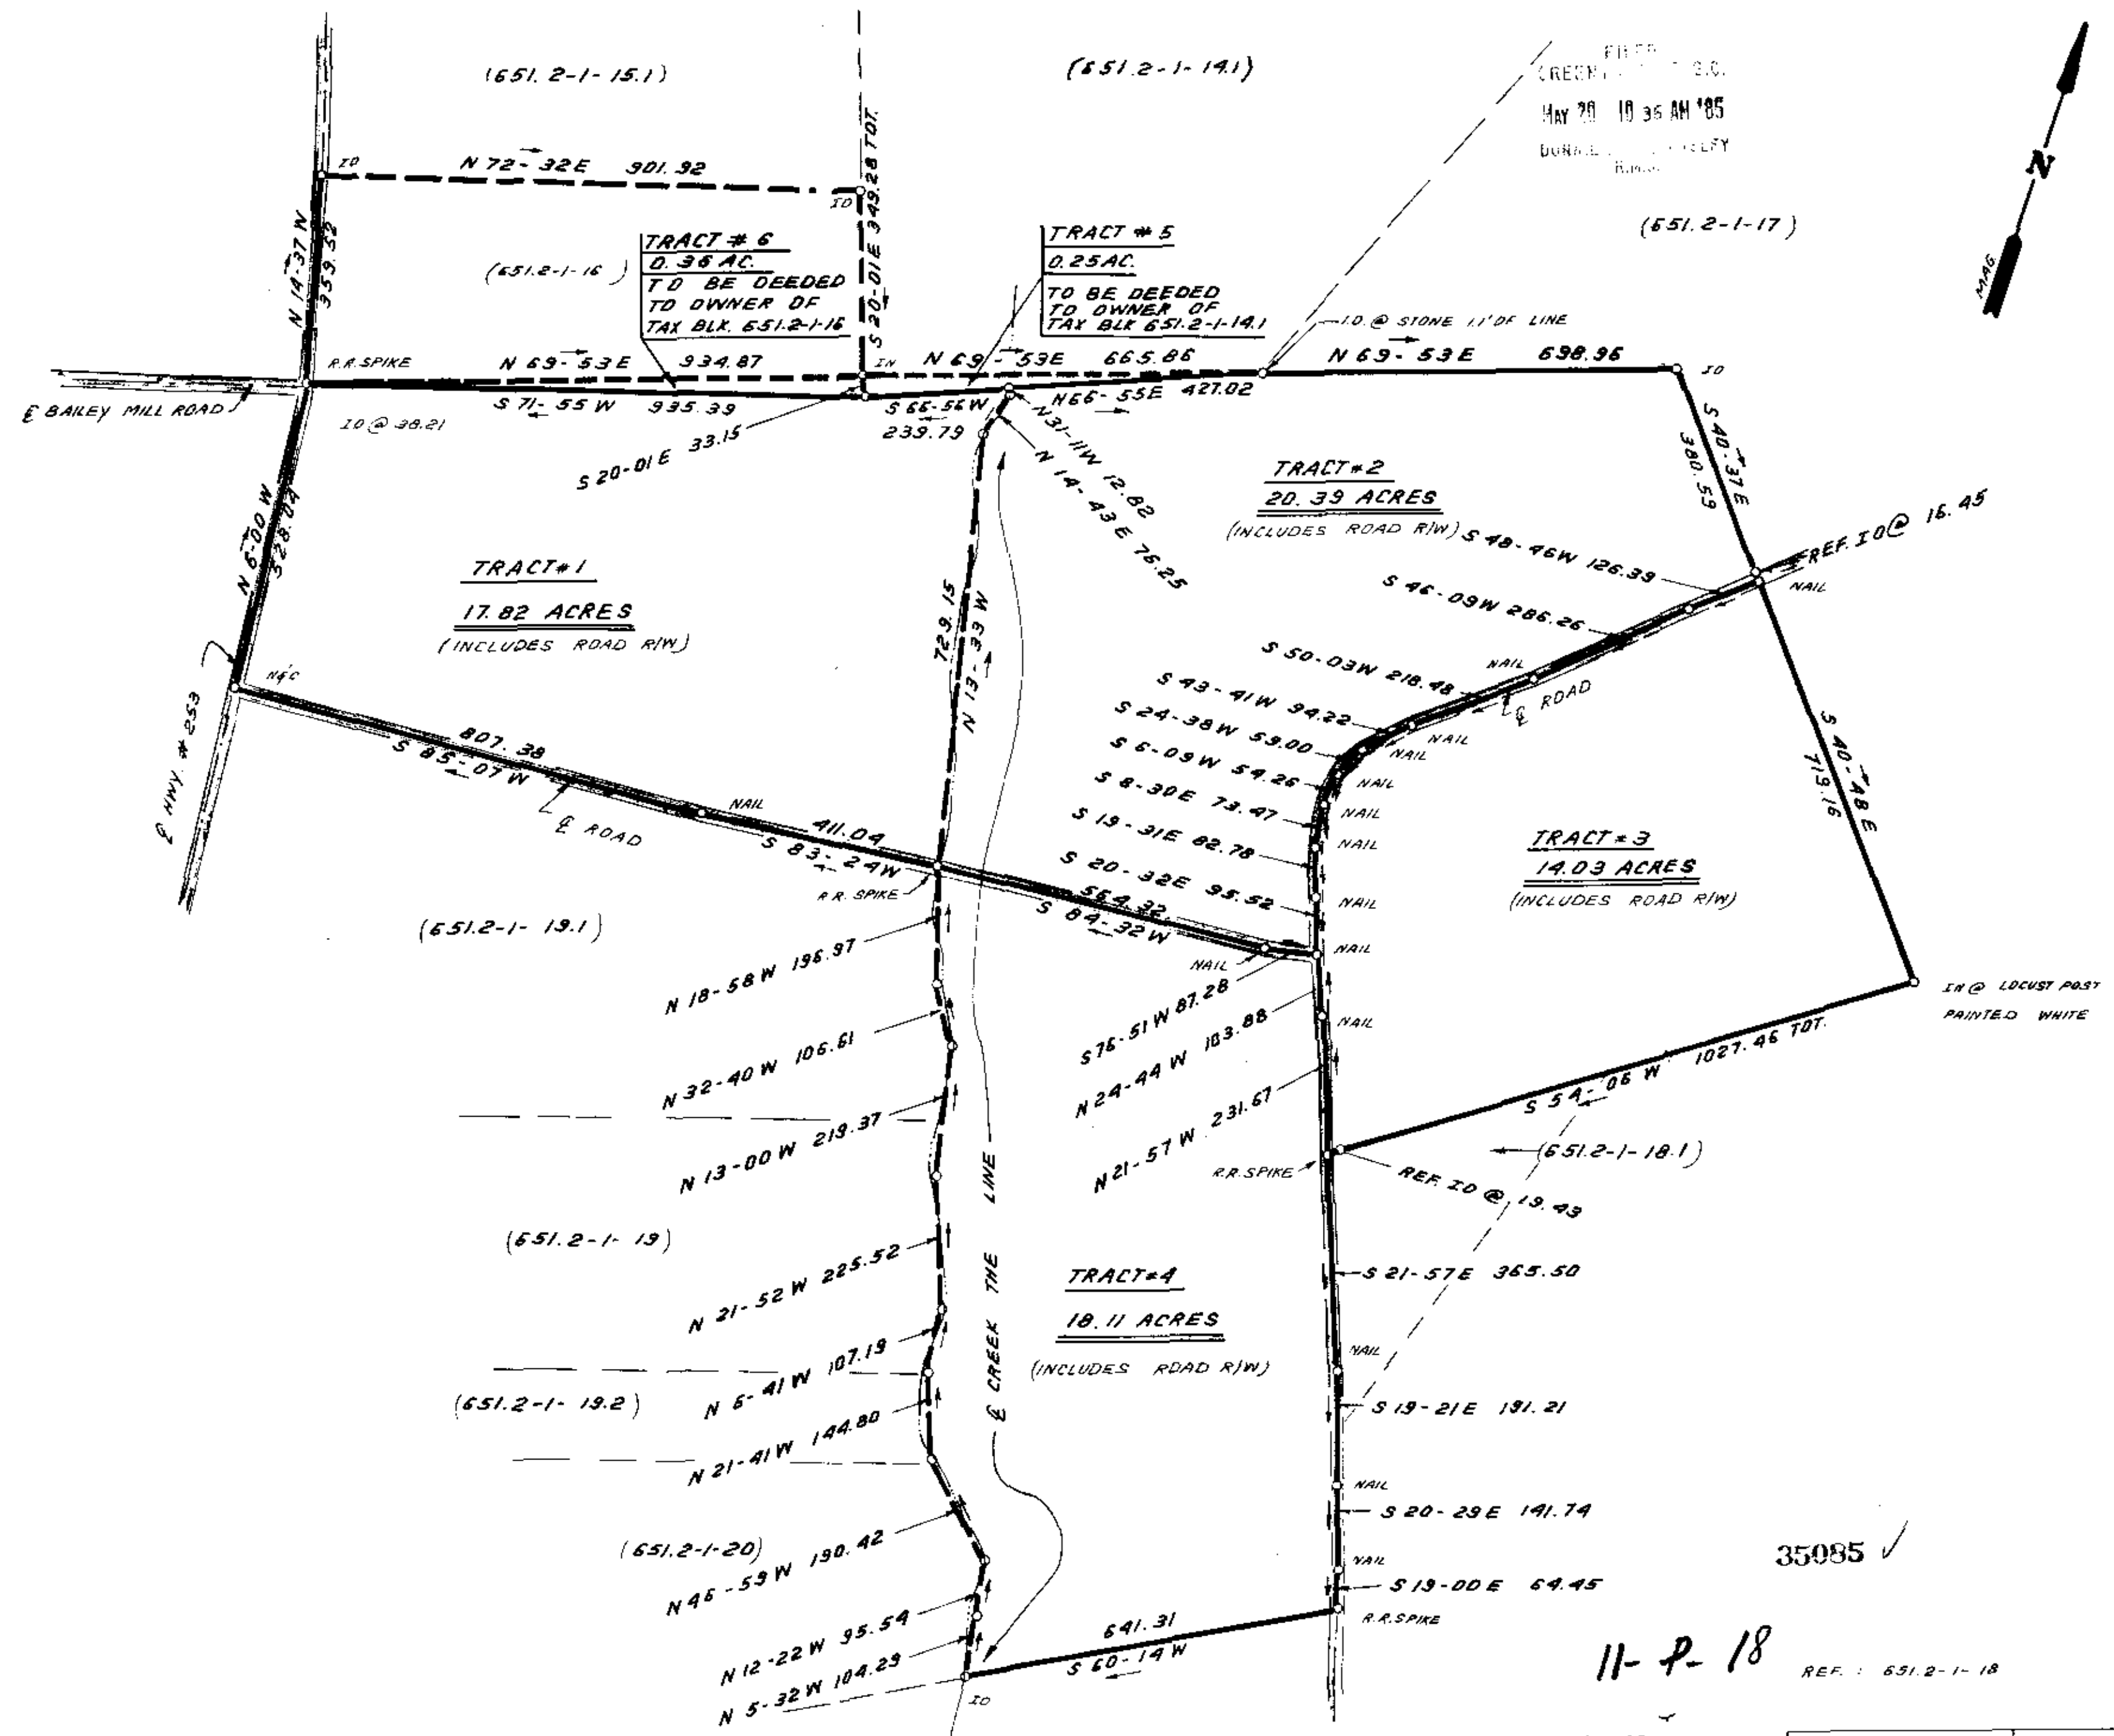

FIELD  
CREEK  
MAY 20 10 36 AM '85  
DUNN  
RURAL

I hereby certify that the ratio of precision of the field survey is 1/5,000 as shown hereon and the area was determined by DMD Method.


James R. Freeland  
James R. Freeland RLS & PE 4781

35085 ✓

11-P-18

REF: 651.2-1-18

MAY 20 1985

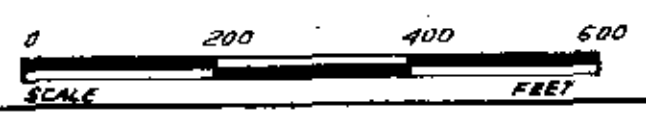

STATE OF SOUTH CAROLINA  
GREENVILLE COUNTY

SURVEY FOR  
PAUL BARTON

FREELAND & ASSOCIATES Engineers & Land Surveyors	
GREENVILLE, S.C.	
SURVEY	B.G.
DRAWN	B.P.
CHECK	
SCALE	1" = 200'
DATE	4-22-85
TOWNSHIP NO.	12.58

GC 70 - MAY 20 1985

REVISED: 5-17-85