FILED
GREENVILLE CO., S.C.
AUG 19 9 59 AM '85
DONNIE S. TANKERSLEY
R.M.C.

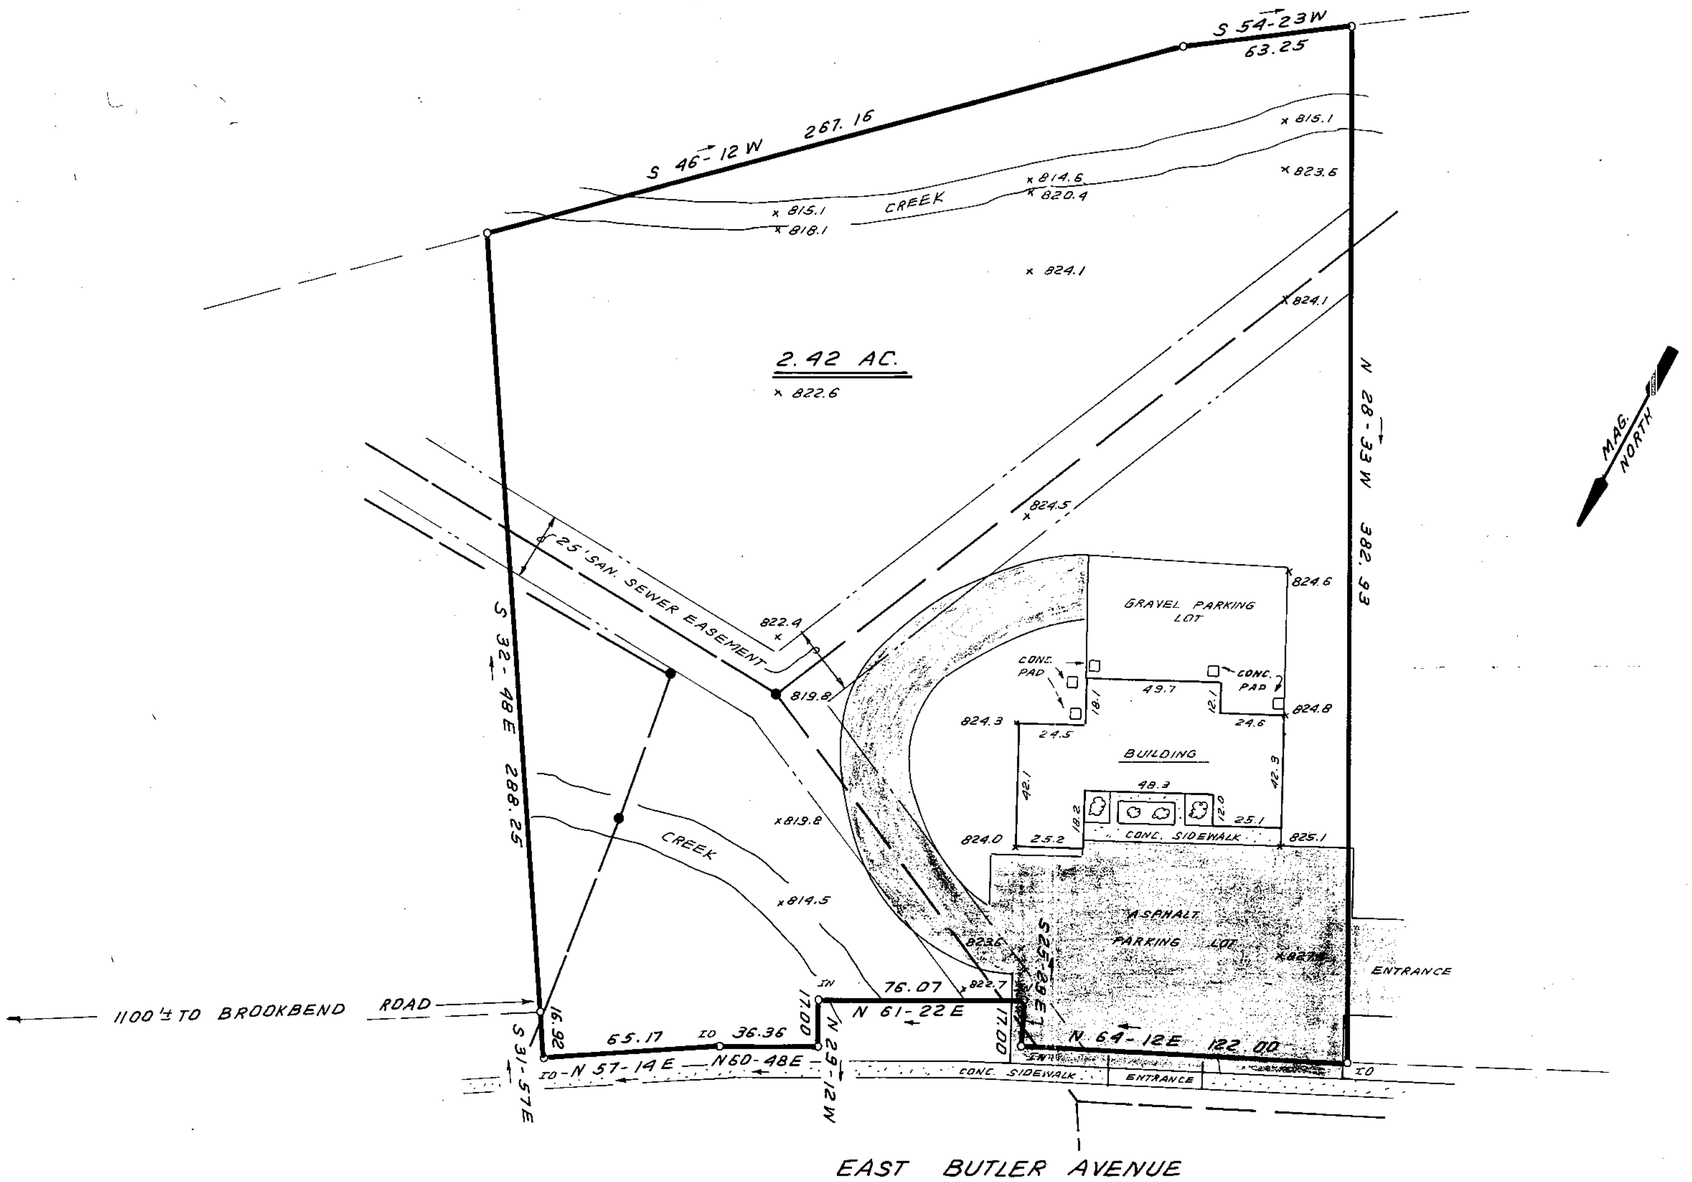

5783

11-P-86

AUG 19 1985

BASE FLOOD ELEV. 821.8

NOTE: THIS BUILDING IS NOT LOCATED IN A DESIGNATED FLOOD HAZARD AREA.

I hereby certify that the ratio of precision of the field survey is 1/5,000 as shown hereon and the area was determined by DMD Method.

James R. Freeland
James R. Freeland RLS & PE 4781

SCALE 0 40 80 120 FEET

SOUTH CAROLINA REGISTERED LAND SURVEYOR JAMES R. FREELAND 11-81
SEAL

STATE OF SOUTH CAROLINA
GREENVILLE COUNTY

RECORD DRAWING
FOR
CHARLES C. BENTLEY

FREELAND & ASSOCIATES
Engineers • Land Surveyors
GREENVILLE, S.C.

SURVEY	R.A.J. & J.G.
DRAWN	B.R.
CHECK	
SCALE	1" = 40'
DATE	8-16-85
DWG. NO.	10725-B

THE PRINT MACHINE, INC. N4337

MICROFILMED