


FILED
 GREENVILLE CO. S.C.
 MAY 30 11 11 AM '85
 DONNIE S. HAMMERSLEY
 R.M.C.

This is to certify that on May 28, 1985, I surveyed the property shown on this plat, known as Unit 9, on plat of Furman Place Phase One, recorded in the R.M.C. Office of Greenville County in Plat 11-I on Page 30, and that the property lines, walls and buildings area as shown hereon, that the building located on said lot does not encroach or project on adjacent streets or property, and that no adjacent walls or buildings encroach or project on said premises, and that no utility lines R/W's cross this property except as shown hereon. This property is not located in a Designated Flood Hazard Area.


36239 ✓
 11-Q-5
 MAY 30 1985

Frederick E. Landrith
 Frederick E. Landrith 9545

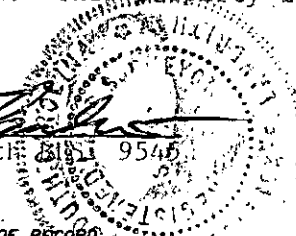

THIS PROPERTY IS SUBJECT TO ANY AND ALL RIGHTS OF WAY AND EASEMENTS OF RECORD.

LANDRITH SURVEYING
 Land Surveys • Topographical Maps
 Construction Layout
 4416 WHITE HORSE ROAD
 GREENVILLE, SOUTH CAROLINA
 40 0 40

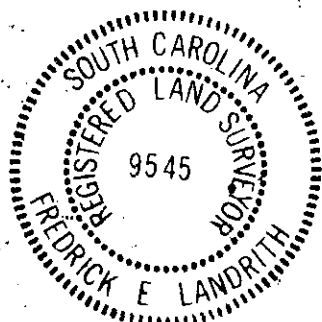

STATE of SOUTH CAROLINA
COUNTY of GREENVILLE
 PHASE ONE
FURMAN PLACE
 UNIT 9
 PROPERTY OF
ROBERT B. McCRARY
CAROL J. McCRARY

SURVEYED BY FEL CK'D BY FEL
 DRAWN BY FEL DATE 5/28/85

SEAL

PROJECT NO. 85 - 278