


FILED
GREENVILLE CO. S.C. 10' ALLEY

MAY 31 11 29 AM '85

DONNIE S. TANKERSLEY
R.M.C.

NEEDON STREET (AVE)

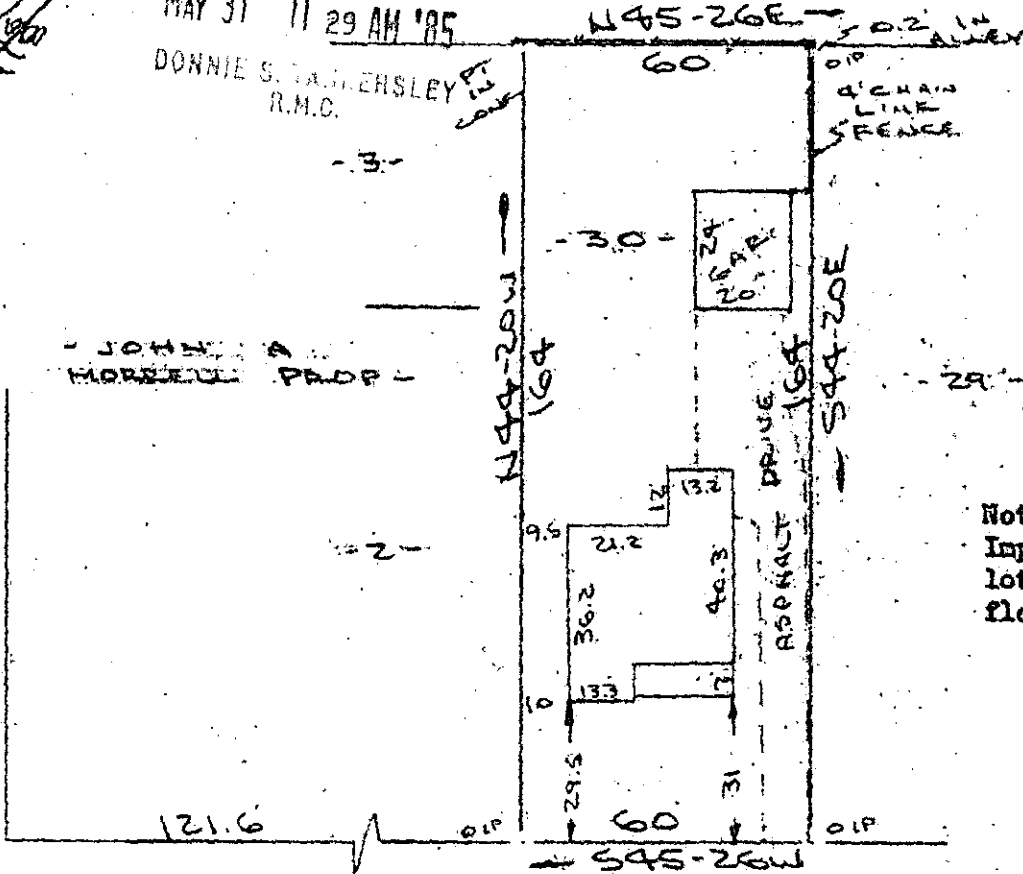


Note:
Improvements on this lot are not in a flood hazard area.

SOUTH FRANKLIN ROAD
WATER & SEWER IN R.O.R./W

PROPERTY OF
RONALD L. SAUDER & FRAN S. SAUDER
NEAR GREENVILLE, S.C.

SCALE: 1" = 40' 30 MAY 1985

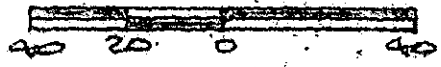

This is to certify that on the 30th day of May, 1985, I surveyed the property shown on this plat, being known as lot 30 on plat of McCULLOUGH HEIGHTS and recorded in the REC Office Greenville County, S. C., in Plat Book "E" at Page 95; and that the property lines, walls and buildings are as shown hereon, and that the walls and buildings located on said lot do not encroach or project on adjacent street or property, and that no adjacent walls or buildings encroach or project on said premises, and no power lines cross this property except as shown hereon.

11Q-23 MAY 31 1985

36542

R. B. Bruce
R. B. Bruce, RLS # 1952

CAROLINA SURVEYING CO.
112 Manly St.
Greenville, S. C.

Recordable Plat