



FILED GREENVILLE CO. S.C.

MAY 31 4 09 PM '85

LUTHI DONNIE S. WARRSLEY R.M.C.

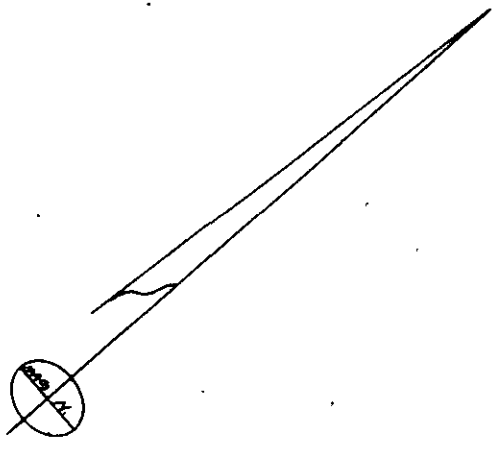

WEST WASHINGTON ST.

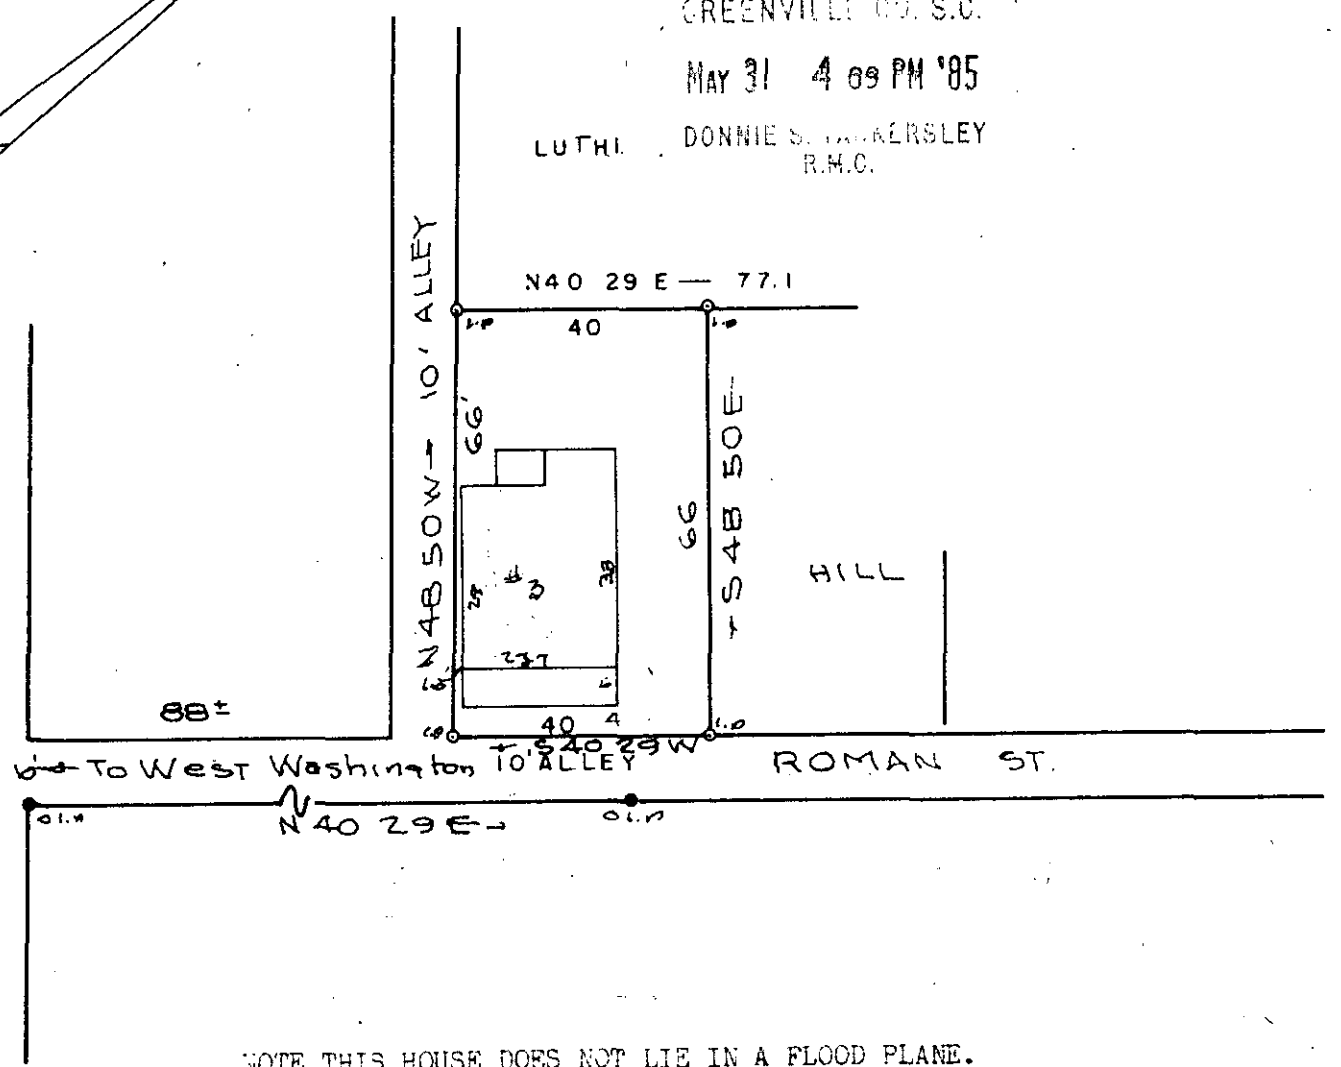

NOTE THIS HOUSE DOES NOT LIE IN A FLOOD PLANE.

MAY 31 1985
11. Q-28

36533

PROPERTY OF STEVEN R. HILL

GREENVILLE CITY S.C

This is to certify that on the 29 day of MAY 1985 I surveyed the property shown on this plat being: PT. LOT 9 McCrory, Bates & Williams PROPERTY BLK. BK. 23 - 2 - PT 19

SCALE 1" = 30' MAY 29-1984

and recorded in Plat Book E, page 240 of the R.M.C. OFFICE FOR GREENVILLE County S.C.

and that the property lines, walls and buildings are as shown hereon; that the buildings located on said lot do not encroach or project on adjacent streets or property; and that no adjacent buildings or walls encroach or project on said premises, and that no utility lines cross this plat, unless shown on plat.

