


REF: DEED BOOK 974 @ PAGE 433.

- JOHN W. GRADY, III -

- JOHN W. GRADY, III -


- DAVID J. & BETH U. HOWACK -

Note: Improvements on this lot are not in a flood hazard area.

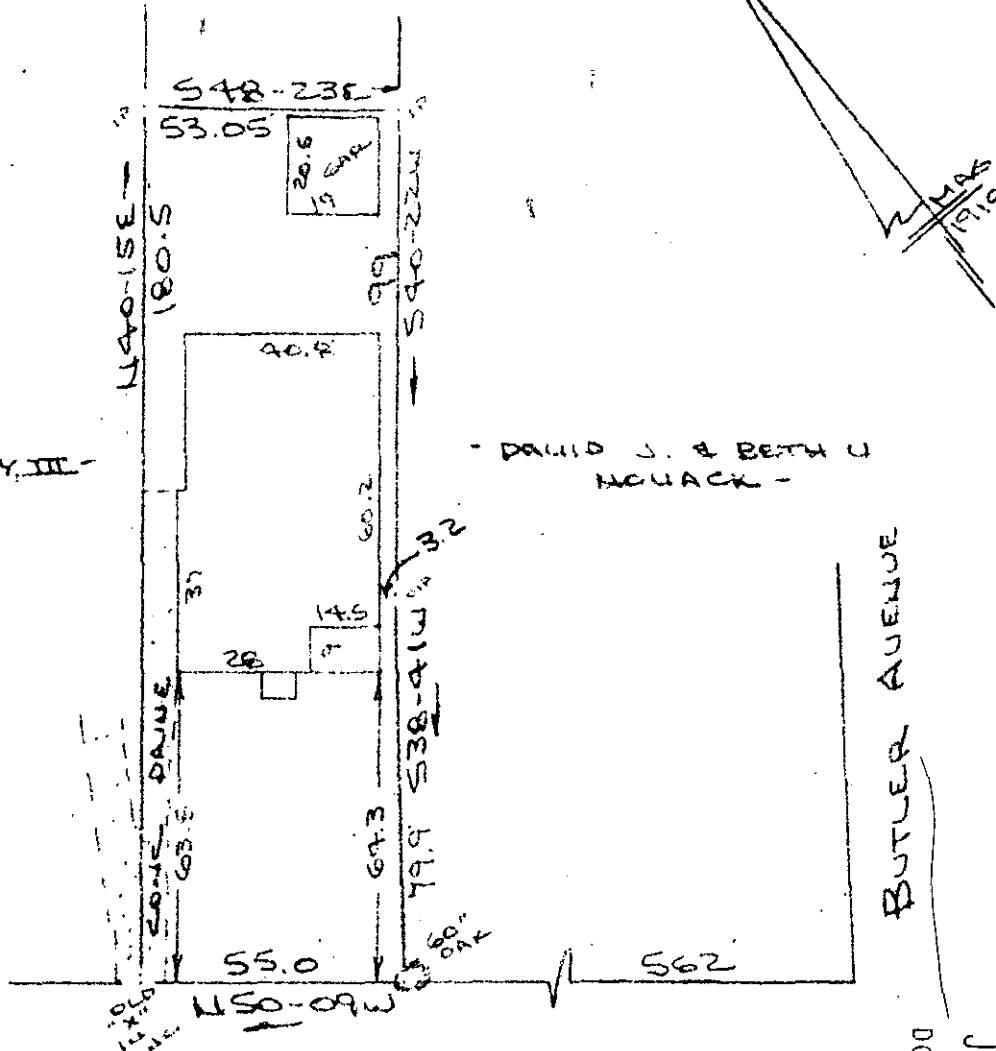

HAMPTON AVENUE
WATER & SEWER IN ST. R/W

PROPERTY OF
PAUL R. WEIDEMAN ✓
GREENVILLE COUNTY, GREENVILLE S.
SCALE: 1" = 40' 3 JUNE 1985

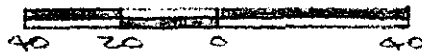

FILED
GREENVILLE CO. S.C.
JUN 4 9 47 AM '85
DONNIE S. ANNERSLEY
R.M.C.

This is to certify that on the 3rd day of June, 1985, I surveyed the property shown on this plat, being known as PROPERTY OF PAUL R. WEIDEMAN and recorded in Plat Book at Page ; and that the property lines, walls and buildings are as shown hereon, and that the walls and buildings located on said lot do not encroach or project on adjacent street or property, and that no adjacent walls or buildings encroach or project on said premises, and no power lines cross this property except as shown hereon.

11-Q-48

37012

JUN 4 1985
R. B. Bruce, RLS # 1952

CAROLINA SURVEYING
112 Manly St.
Greenville, S.C.

co. Recordable Plat

300 8 21801