MICROFILMED

Note: There will be a 5 ' utility & drainage easement along each side lot line and 12.5 ' at each rear lot line.

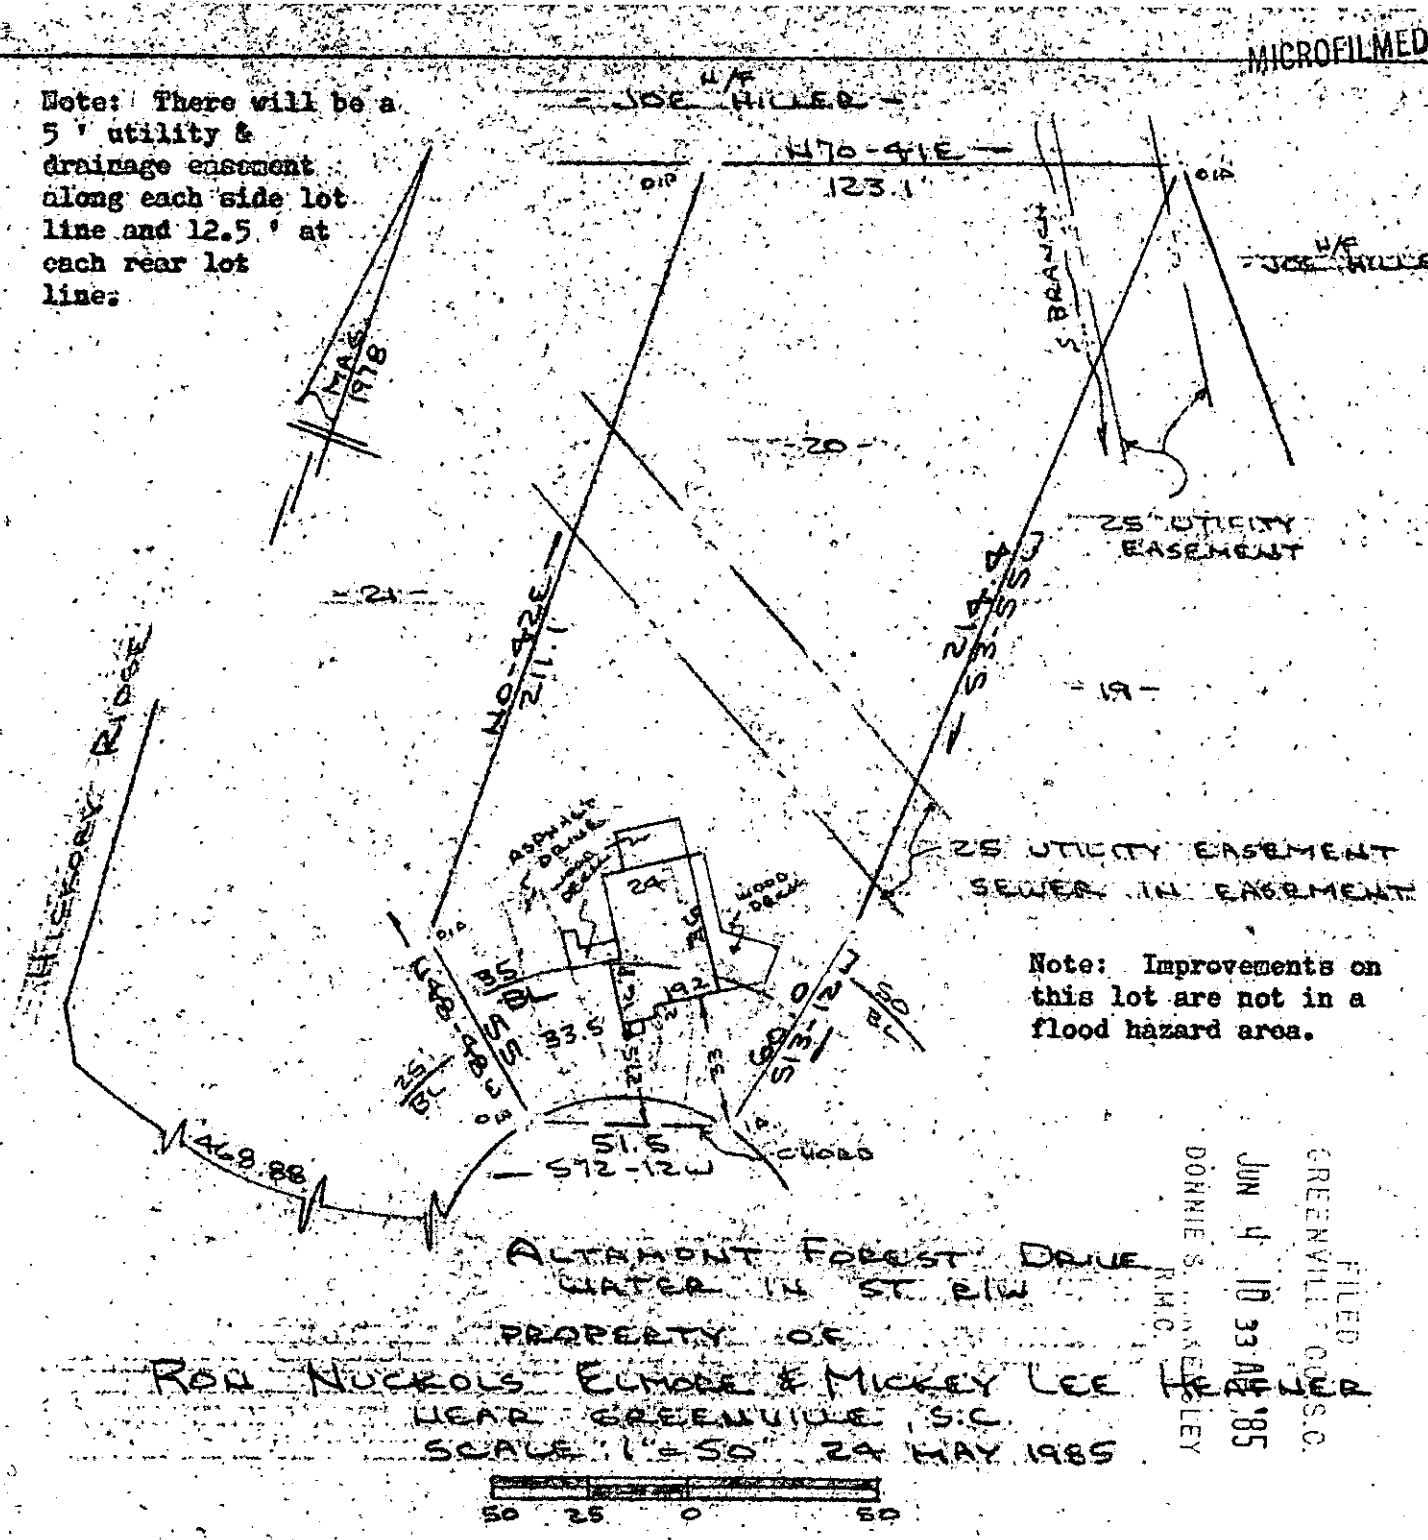


Note: Improvements on this lot are not in a flood hazard area.

FILED
GREENVILLE CO. S.C.
JUN 4 10 33 AM '85
DONNIE S. TANKERSLEY
R.M.C.

This is to certify that on the 24th day of May, 1985, I surveyed the property shown on this plat, being known as lot 20 on plat of ALTAMONT FOREST and recorded in the RMC Office Greenville County, S. C., in Plat Book " 6 - H " at Page 42; and that the property lines, walls and buildings are as shown hereon, and that the walls and buildings located on said lot do not encroach or project on adjacent street or property, and that no adjacent walls or buildings encroach or project on said premises, and no power lines cross this property except as shown hereon.

JUN 4 1985

11-Q-49

37011

Recordable Plat

R. B. Bruce

CAROLINA SURVEYING CO.
112 Manly St.
Greenville, S. C.

R. B. Bruce, RLS # 1952