MICROFILMED

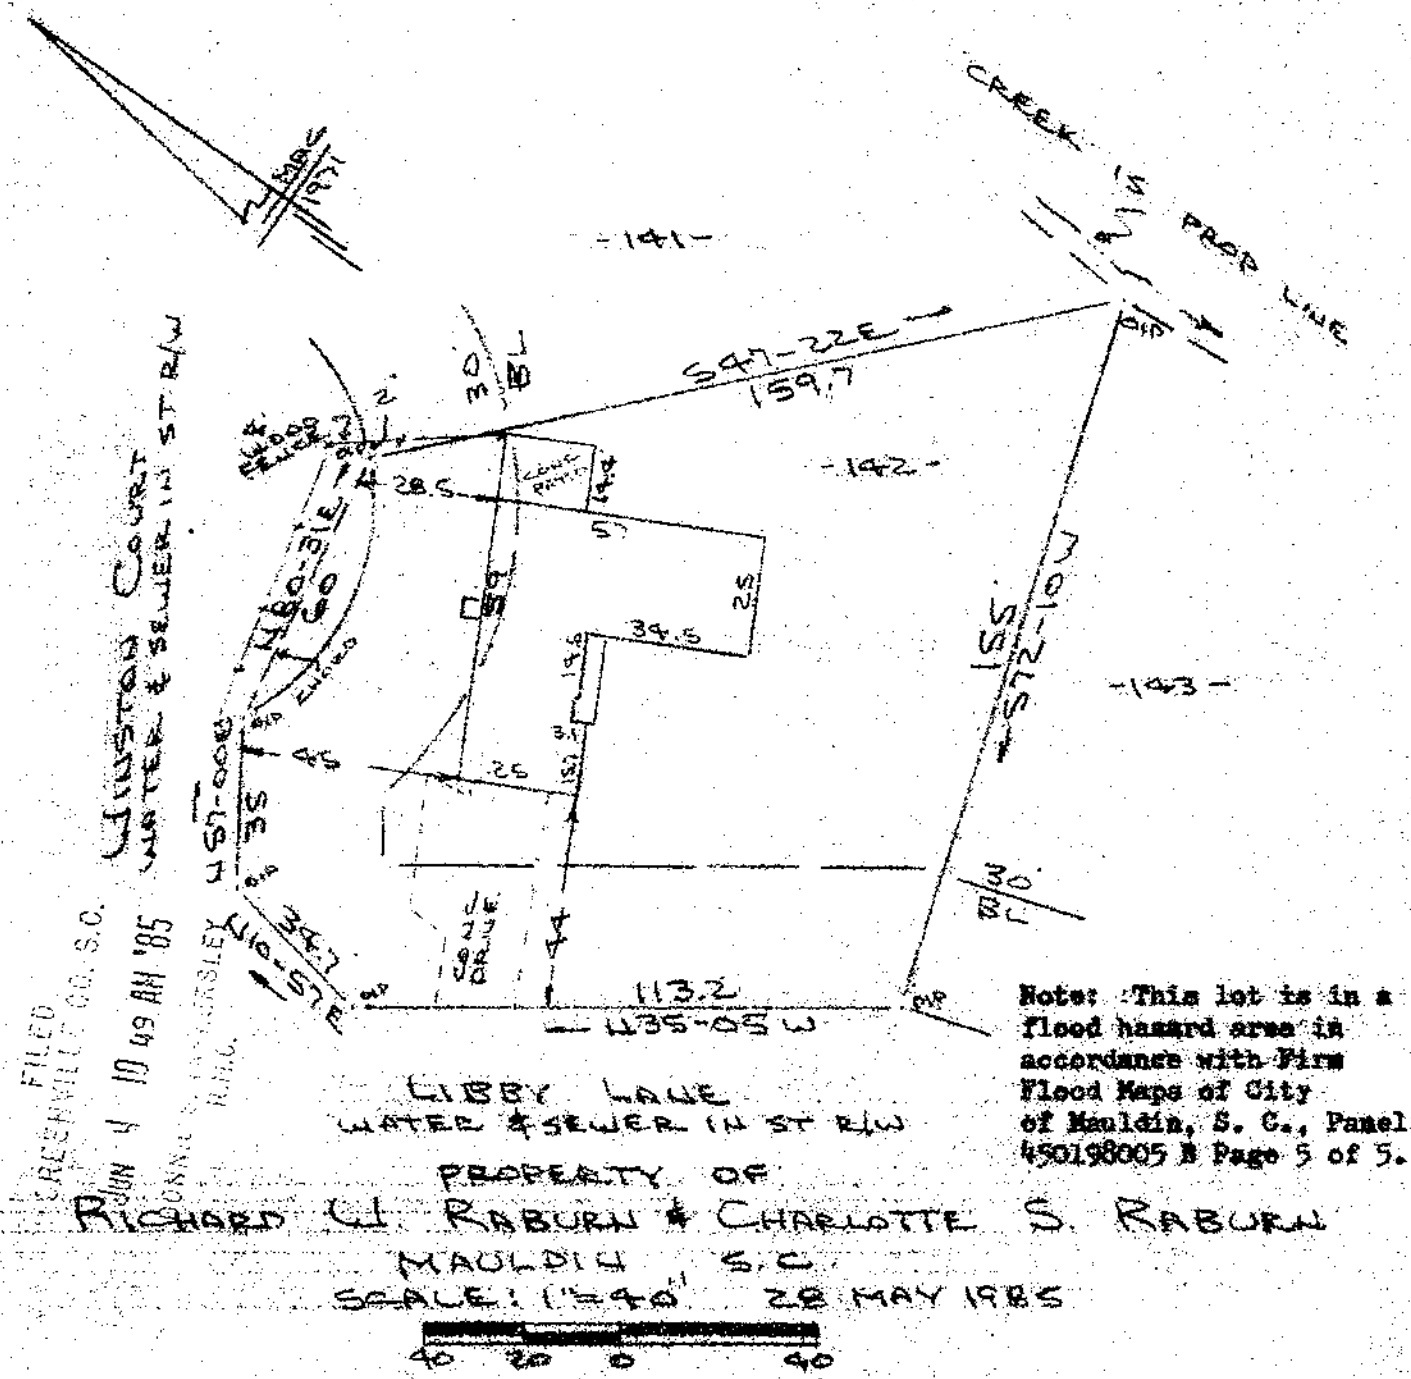

Note: This lot is in a flood hazard area in accordance with Firm Flood Maps of City of Mauldin, S. C., Panel 450198005 B Page 5 of 5.

PROPERTY OF
RICHARD U. RABURN & CHARLOTTE S. RABURN
MAULDIN S.C.
SCALE: 1"=40' 28 MAY 1985

40 20 0 40

This is to certify that on the 28th day of May, 1985, I surveyed the property shown on this plat, being known as lot 142 on plat of SECTION 3 HILLSBOROUGH and recorded in the RMC Office Greenville County, S. C., in Plat Book " 4 - N " at Page 42; and that the property lines, walls and buildings are as shown hereon, and that the walls and buildings located on said lot do not encroach or project on adjacent street or property, and that no adjacent walls or buildings encroach or project on said premises, and no power lines cross this property except as shown hereon.

11-Q-57

JUN 4 1985

37009

R. B. Bruce

R. B. Bruce, RLS #1952

CAROLINA SURVEYING CO.
112 Manly St.
Greenville, S. C.

Recordable Plat

FILED
JUN 4 10 49 AM '85
GREENVILLE CO. S.C.

283/59A

M4.5-1-141