


7

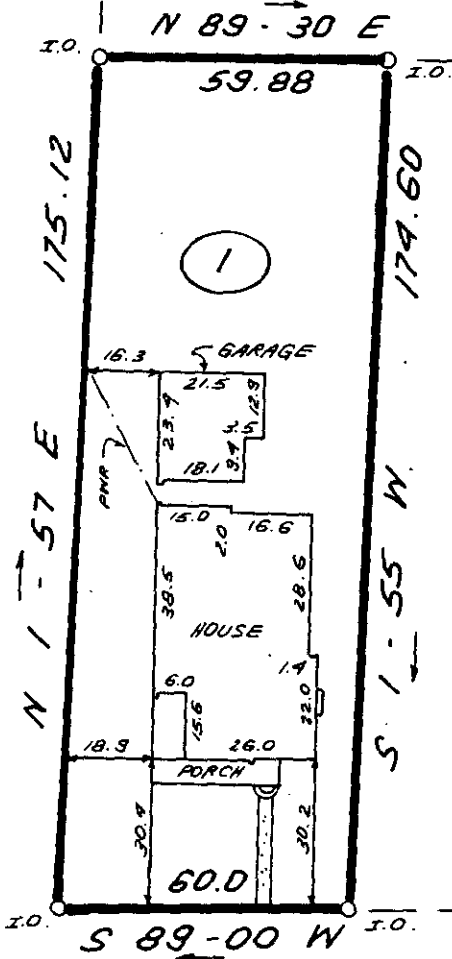


HOUSTON STREET



2

FILED
 GREENVILLE, S.C.
 JUN 7 12 19 PM '85
 DONNIE S. JAKERSLEY
 R.M.C.


TINDAL AVENUE

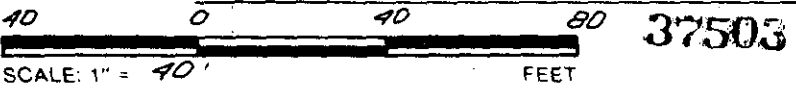

11-2-66

THIS IS TO CERTIFY THAT THE PROPERTY SHOWN ON THIS PLAT WAS SURVEYED UNDER MY DIRECT SUPERVISION PROPERTY LINES AND IMPROVEMENTS SHOWN ARE LOCATED CORRECTLY AND THAT NO VISIBLE ENCROACHMENTS EXIST UNLESS OTHERWISE SHOWN. THIS PROPERTY IS NOT LOCATED IN A DESIGNATED FLOOD HAZARD AREA.

300 3 31A01

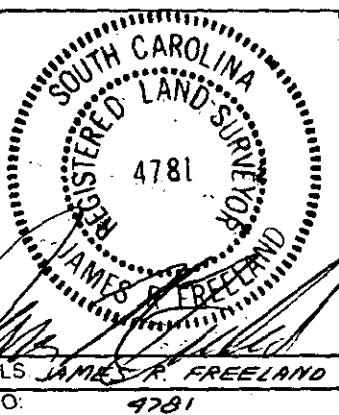

**STATE OF SOUTH CAROLINA
 GREENVILLE COUNTY**

ESTATE OF
MRS. STELA K. TINDAL
LOT 1
PROPERTY OF
CHARLES PELLETT

FREELAND & ASSOCIATES
 Engineers • Land Surveyors
 318 WEST STONE AVENUE.
 GREENVILLE, S.C.
 (803) 271-4924

PLAT BOOK	H @ 280
DEED BOOK	161 @ 559
TAX MAP	93 -1-38
PARTY CHIEF	J.E.C.
DRAWN	K.E.G
DATE	5-23-85
DWG. NO.	13095