


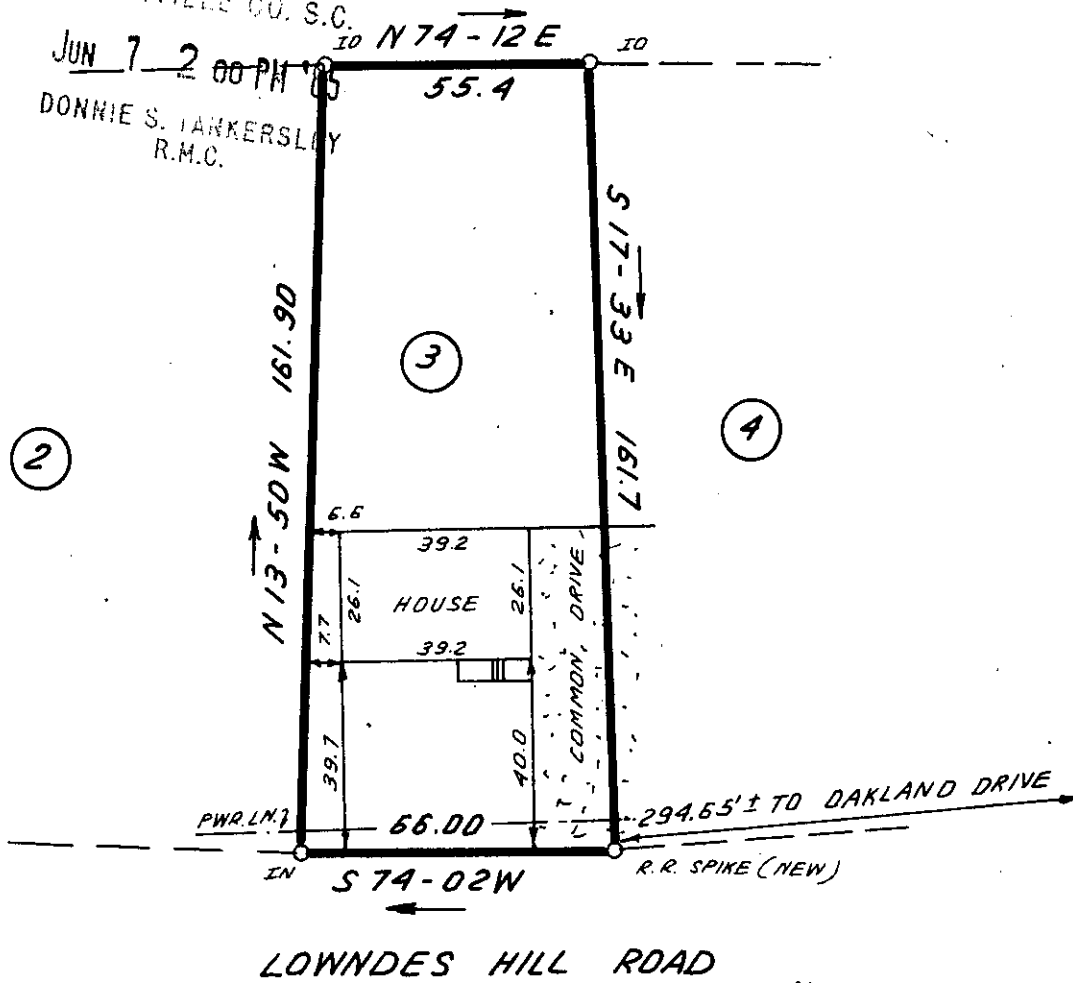

FILED
GREENVILLE CO. S.C.
JUN 7 2 00 PM '85
DONNIE S. JANKERSLKY
R.M.C.



JUN 7 1985

37501

11-Q-68



THIS IS TO CERTIFY THAT THE PROPERTY SHOWN ON THIS PLAT WAS SURVEYED UNDER MY DIRECT SUPERVISION. PROPERTY LINES AND IMPROVEMENTS SHOWN ARE LOCATED CORRECTLY AND THAT NO VISIBLE ENCROACHMENTS EXIST UNLESS OTHERWISE SHOWN. THIS PROPERTY IS NOT LOCATED IN A DESIGNATED FLOOD HAZARD AREA.

SOUTH CAROLINA
REGISTERED LAND SURVEYOR
JAMES R. FREELAND

FLS: JAMES R. FREELAND
NO: 4781

**STATE OF SOUTH CAROLINA
GREENVILLE COUNTY**

KENNETH BENTLEY PROP.

LOT 3

PROPERTY OF

NORMAN M. WATKINS

FREELAND & ASSOCIATES
Engineers • Land Surveyors
318 WEST STONE AVENUE.
GREENVILLE, S.C.
(803) 271-4924

PLAT BOOK	4N-39
DEED BOOK	1007-257
TAX MAP	193.3-4-11
PARTY CHIEF	J.E.C.
DRAWN	B.R.
DATE	APRIL 19 1985
DWG. NO.	10,934-2