


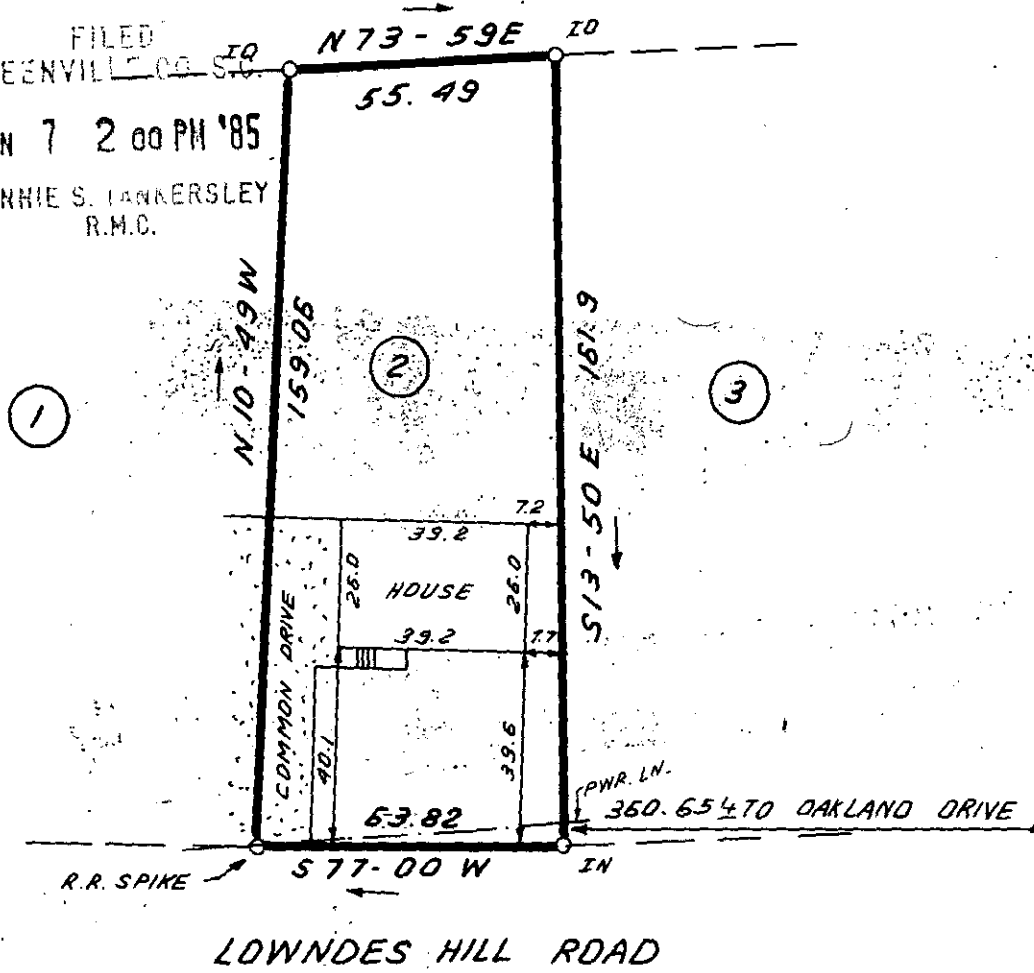

FILED
GREENVILLE CO. S.C.
JUN 7 2 00 PM '85
DONNIE S. JANKERSLEY
R.M.C.



JUN 7 1985

37502 ✓ 11-Q-69

SCALE: 1" = 40 FEET

THIS IS TO CERTIFY THAT THE PROPERTY SHOWN ON THIS PLAT WAS SURVEYED UNDER MY DIRECT SUPERVISION. PROPERTY LINES AND IMPROVEMENTS SHOWN ARE LOCATED CORRECTLY AND THAT NO VISIBLE ENCROACHMENTS EXIST UNLESS OTHERWISE SHOWN. THIS PROPERTY IS NOT LOCATED IN A DESIGNATED FLOOD HAZARD AREA.

SOUTH CAROLINA
REGISTERED LAND SURVEYOR
18781
JAMES R. FREELAND

RLS: JAMES R. FREELAND
NO: 4781

**STATE OF SOUTH CAROLINA
GREENVILLE COUNTY**

KENNETH BENTLEY PROP.
LOT 2
PROPERTY OF

JAMES C. WATKINS

REC'D JUN 27 85

FREELAND & ASSOCIATES
Engineers • Land Surveyors
318 WEST STONE AVENUE.
GREENVILLE, S.C.
(803) 271-4924

PLAT BOOK 4N - 39
DEED BOOK 1007 - 257
TAX MAP 193.3-4-11
PARTY CHIEF J.E.C.
DRAWN B.R.
DATE APRIL 19 85
DWG. NO. 10,934-1