



FILED
GREENVILLE CO. S.C.

JUN 7 3 41 PM '85

SOONHIE S. HARRERSLEY
R.M.C.

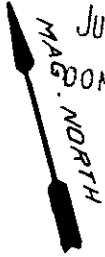

KIRKWOOD LANE

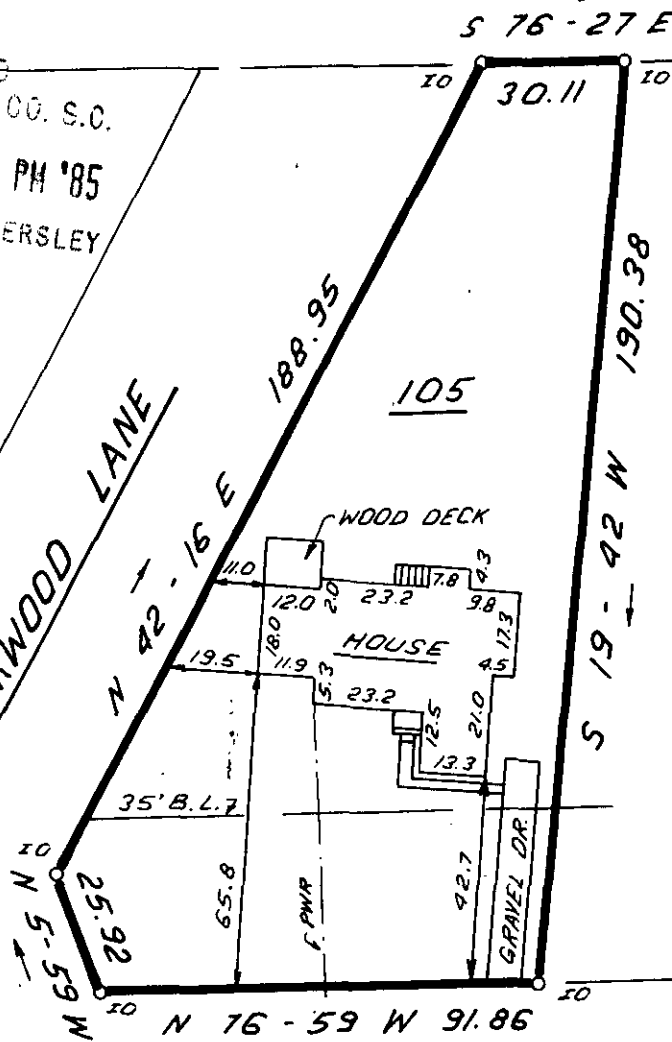

DU PONT DRIVE JUN 7 1985

11-Q-72

37505



THIS IS TO CERTIFY THAT THE PROPERTY SHOWN ON THIS PLAT WAS SURVEYED UNDER MY DIRECT SUPERVISION PROPERTY LINES AND IMPROVEMENTS SHOWN ARE LOCATED CORRECTLY AND THAT NO VISIBLE ENCROACHMENTS EXIST UNLESS OTHERWISE SHOWN. THIS PROPERTY IS NOT LOCATED IN A DESIGNATED FLOOD HAZARD AREA

SOUTH CAROLINA
REGISTERED PROFESSIONAL SURVEYOR
4781
JAMES R. FREELAND

RLS: **JAMES R. FREELAND**
NO: **4781**

**STATE OF SOUTH CAROLINA
GREENVILLE COUNTY**

ISAUQUEENA PARK
LOT 105
PROPERTY OF
KEITH E. GIBSON
MARJORIE J. GIBSON

FREELAND & ASSOCIATES
Engineers • Land Surveyors
318 WEST STONE AVENUE.
GREENVILLE, S.C.
(803) 271-4924

PLAT BOOK	P - 130
DEED BOOK	1081 - 544
TAX MAP	189.2-1-1
PARTY CHIEF	B.C.
DRAWN	I.R.
DATE	6-6-85
DWG. NO	13154