

MICROFILMED

OTIS AVENUE

N71-35E

67.05

20




ASPHALT PARKING

N71-37W

81.04

CONC. SIDEWALK

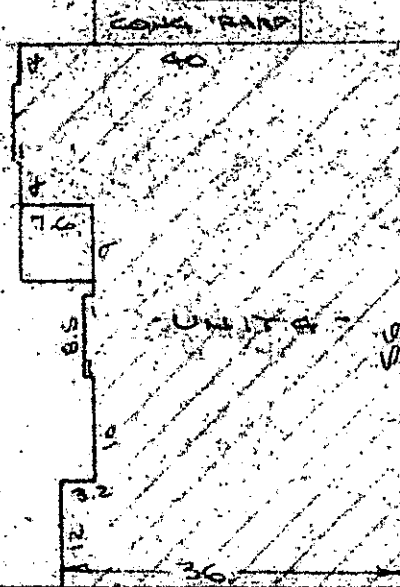


S17-56E

VIRGINIA W. E. BOSE T. MOORE

FILED  
GREENVILLE CO. S.C.  
JUN 18 10 44 AM '85  
R.M.C. HARRISLEY

Note:  
Improvements  
on this lot  
are not in a  
flood hazard  
area.

PROPERTY OF  
WILLIAM E. BOHAR JR., M. D.  
GREENVILLE COUNTY, GREENVILLE, S.C.  
SCALE: 1"=20' 4 JUNE 1985

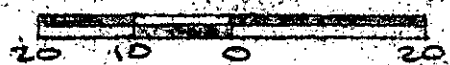

This is to certify that on the 4th day of June, 1985, I surveyed the property shown on this plat, being known as Unit 4 on plat of PROPERTY OF WILLIAM E. BOHAR, Jr., M. D. and recorded in the RMC Office Greenville County, S. C., in Plat Book at Page ; and that the property lines, walls and buildings are as shown hereon, and that the walls and buildings located on said lot do not encroach or project on adjacent street or property, and that no adjacent walls or buildings encroach or project on said premises, and no power lines cross this property except as shown hereon.

38576 ✓

11-A-100

JUN 18 1985

R. B. BRUCE  
R. B. BRUCE, L.S. # 1952  
Recordable Plat  
BRUCE

CAROLINA SURVEYING CO.  
112 Manly St.  
Greenville, S.C. 29605

3.0000

7.02/40

AG-5-DT2

710000

20431