MICROFILMED

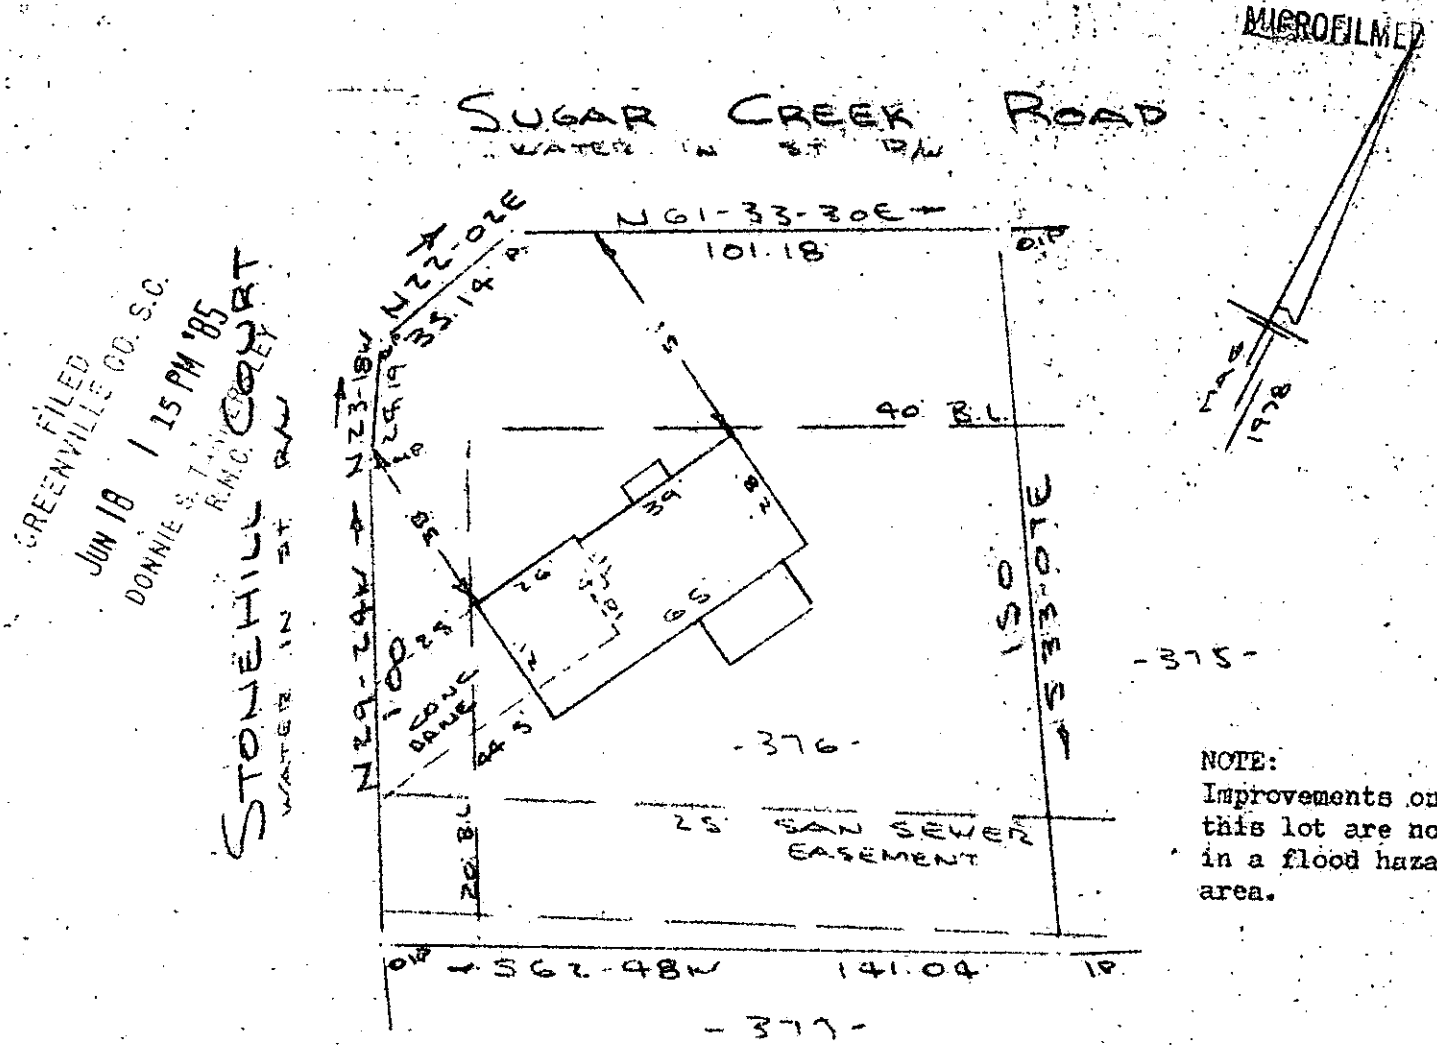

NOTE:
Improvements on this lot are not in a flood hazard area.

PROPERTY OF

RICHARD A. POPPLER & ROSE MARIE POPPLER

NEAR GREENVILLE, S.C.

SCALE 1" = 40' 14 JUNE 1985

40 20 0 40

This is to certify that on the 14th day of June, 1985, I surveyed the property shown on this plat, being known as lot 376 on plat of Map No. 6 SUGAR CREEK and recorded in the RMC Office Greenville County, S. C., in Plat Book " 6 - H " at Page 63; and that the property lines, walls and buildings are as shown hereon, and that the walls and buildings located on said lot do not encroach or project on adjacent street or property, and that no adjacent walls or buildings encroach or project on said premises, and no power lines cross this property except as shown hereon.

JUN 18 1985

11R-2

38569

R. B. Bruce

R. B. Bruce, RLS #1952

Recordable Plat

CAROLINA SURVEYING CO.
112 Manly St.
Greenville, S. C.

300 8 3180

182 @ 80A

539.3-1-37C