
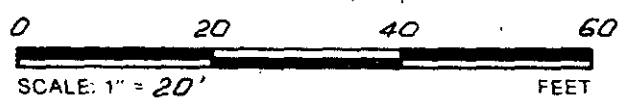


— FOREST LAKES, SEC. 1, PHASE 2 —

PROP. LINE

DRIVE WAY

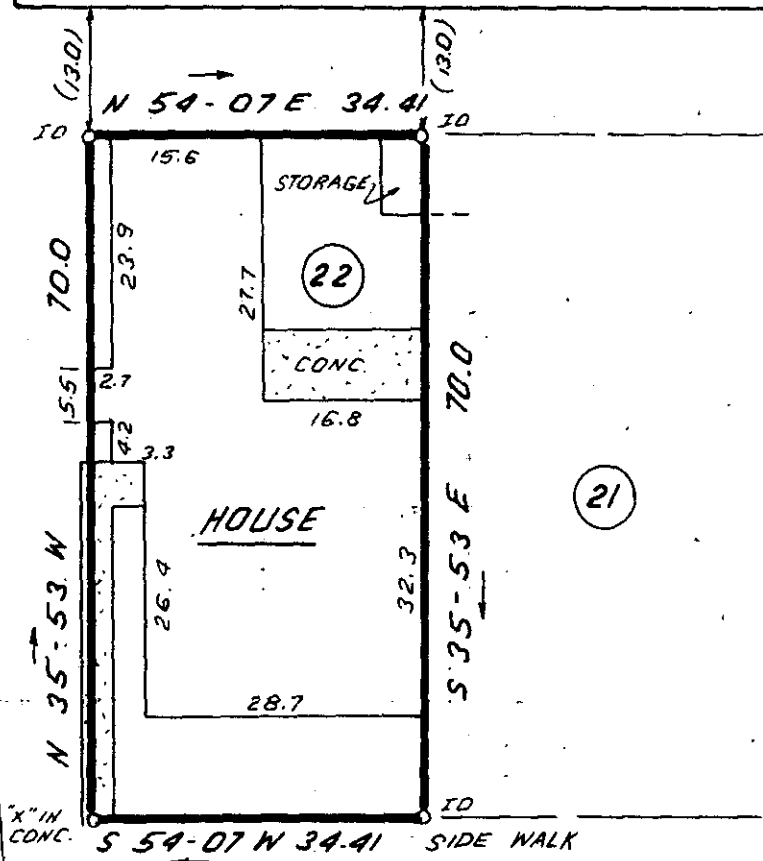

38568


JUN 18 1985

11-R-4

FILED
 GREENVILLE CO. S.C.
 JUN 18 2 44 PM '85
 DONNIE S. JAMMERSLEY
 R.M.C.

THIS IS TO CERTIFY THAT THE PROPERTY SHOWN ON THIS PLAT WAS SURVEYED UNDER MY DIRECT SUPERVISION. PROPERTY LINES AND IMPROVEMENTS SHOWN ARE LOCATED CORRECTLY AND THAT NO VISIBLE ENCROACHMENTS EXIST UNLESS OTHERWISE SHOWN. THIS PROPERTY IS NOT LOCATED IN A DESIGNATED FLOOD HAZARD AREA

1323

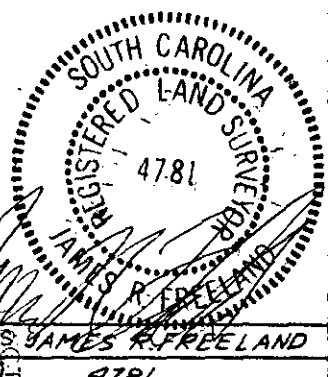

**STATE OF SOUTH CAROLINA
 GREENVILLE COUNTY**

FREELAND & ASSOCIATES
 Engineers • Land Surveyors
 318 WEST STONE AVENUE.
 GREENVILLE, S.C.
 (803) 271-4924

FOREST LAKE
SEC. 1; PHASE 1; LOT 22
PROPERTY OF
RONNIE K. BUHRMASTER
CATHY O. BUHRMASTER

PLAT BOOK	// I-6
DEED BOOK	
TAX MAP	
PARTY CHIEF	J.C.
DRAWN	J.R.
DATE	4-24-85
DWG. NO.	12876