



MICROFILMED

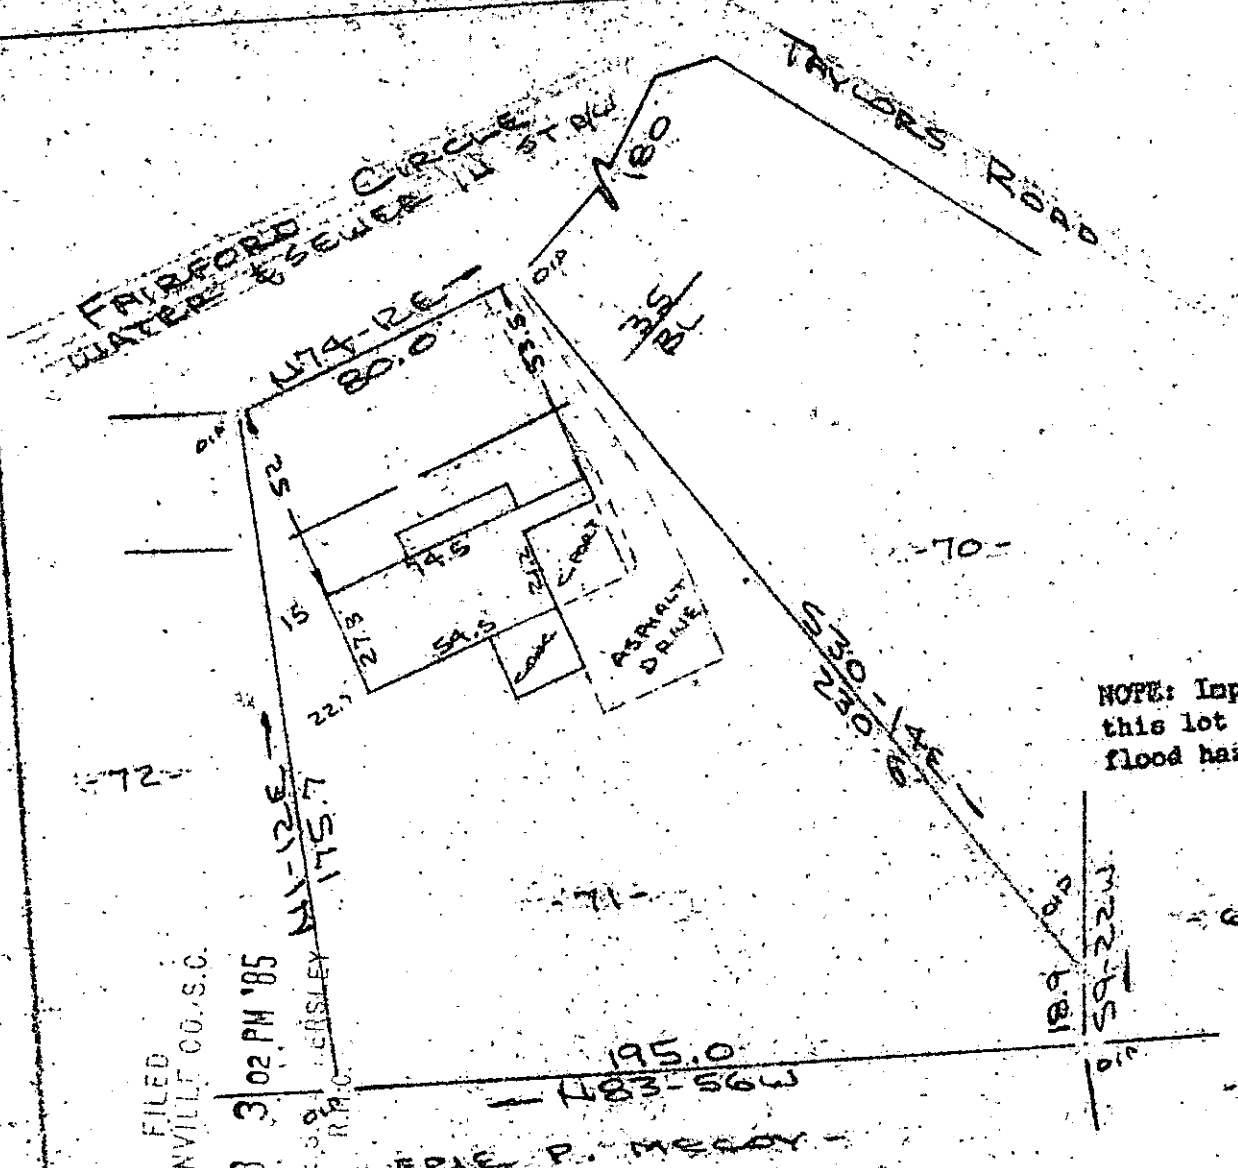

NOTE: Improvements on this lot are not in a flood hazard area.

FILED  
GREENVILLE CO. S.C.  
JUN 18 3 02 PM '85  
DONNIE S. GIBBS  
R.M.C.

PROPERTY OF  
**JACOB G. MASTERS & JACOB D. MASTERS**  
NEAR GREENVILLE, S.C.  
SCALE 1" = 50'

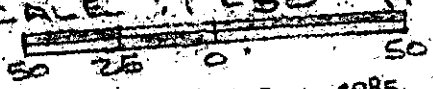

This is to certify that on the 11th day of June 1985, I surveyed the property shown on this plat, being known as lot 71 on plat of SECTION FIVE COLONIAL HILLS and recorded in the REC Office Greenville County, S. C., in Plat Book "000" at Page 21; and that the property lines, walls and buildings are as shown hereon, and that the walls and buildings located on said lot do not encroach or project on adjacent street or property, and that no adjacent walls or buildings encroach or project on said premises, and no power lines cross this property except as shown hereon.

38567

11-R-5

JUN 18 1985

*R. B. Bruce*  
R. B. Bruce, RLS #1952

Recordable Plat

CAROLINA SURVEYING CO.  
112 Manly St.  
Greenville, S. C.

3.00 e 3.1801

T34.1-2-44