MICROFILMED

FILED
GREENVILLE CO. S.C.
JUN 19 4 08 PM '85
DONNIE S. TANKERSLEY
R.M.C.

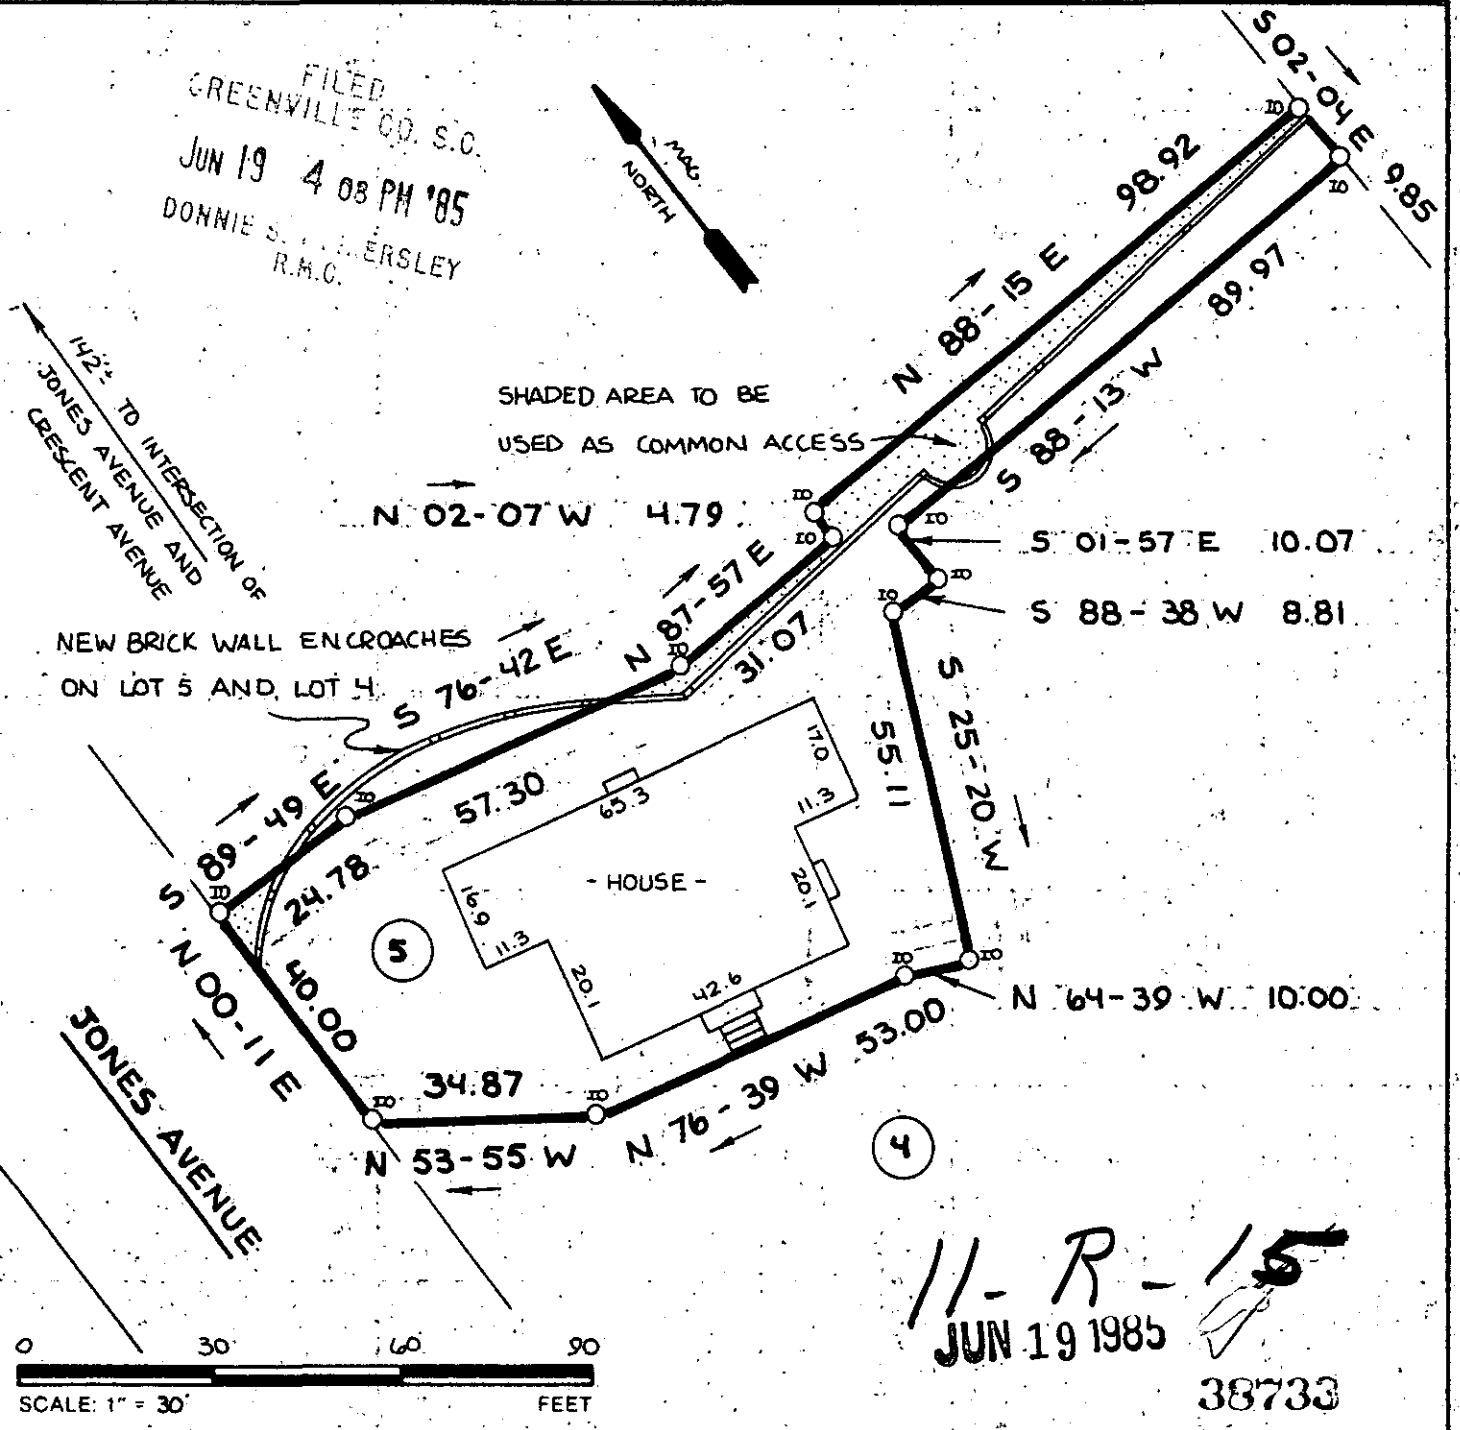

11-R-15

JUN 19 1985

38733

THIS IS TO CERTIFY THAT THE PROPERTY SHOWN ON THIS PLAT WAS SURVEYED UNDER MY DIRECT SUPERVISION. PROPERTY LINES AND IMPROVEMENTS SHOWN ARE LOCATED CORRECTLY AND THAT NO VISIBLE ENCROACHMENTS EXIST UNLESS OTHERWISE SHOWN. THIS PROPERTY IS NOT LOCATED IN A DESIGNATED FLOOD HAZARD AREA

SOUTH CAROLINA REGISTERED LAND SURVEYOR 4781 JAMES R. FREELAND

RLS JAMES R. FREELAND
NO 4781

STATE OF SOUTH CAROLINA
GREENVILLE COUNTY

CRESCENT PLACE
LOT 5
PROPERTY OF
ROSE W. GLOVER

3 JUN 1985

FREELAND & ASSOCIATES
Engineers • Land Surveyors
318 WEST STONE AVENUE.
GREENVILLE, S.C.
(803) 271-4924

PLAT BOOK	9 W - 1 - 00 (D)
DEED BOOK	1236 - 777
TAX MAP	92 - 7 - 12
PARTY CHIEF	GP
DRAWN	DRD
DATE	6/18/85
DWG. NO.	13233

THE PRINT MACHINE, INC. N48640