


HERITAGE LAKES

FILED
GREENVILLE CO. S. 0282.36' TO
JUN 21 1 31 PM '85
DONNIE S. JANKERSLEY
R.M.C.

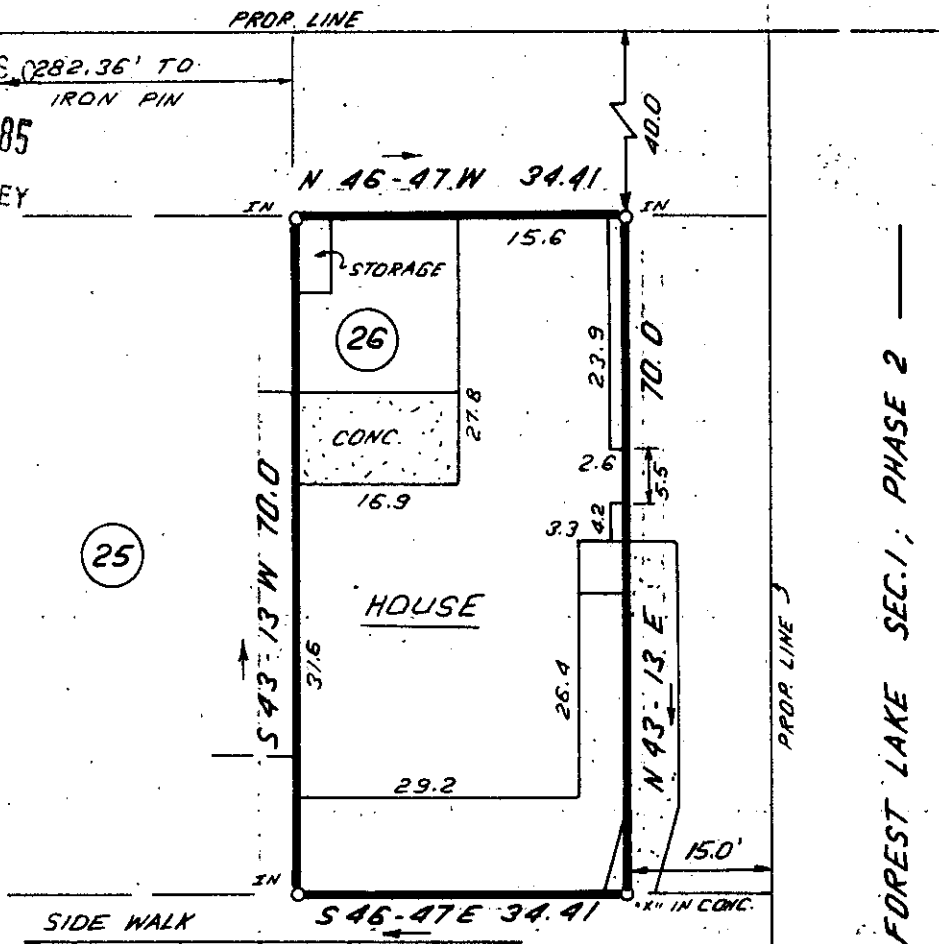

FOREST LAKE SEC. 1; PHASE 2

JUN 21 1985



11-R-26 39052

THIS IS TO CERTIFY THAT THE PROPERTY SHOWN ON THIS PLAT WAS SURVEYED UNDER MY DIRECT SUPERVISION. PROPERTY LINES AND IMPROVEMENTS SHOWN ARE LOCATED CORRECTLY AND THAT NO VISIBLE ENCROACHMENTS EXIST UNLESS OTHERWISE SHOWN THIS PROPERTY IS NOT LOCATED IN A DESIGNATED FLOOD HAZARD AREA

SOUTH CAROLINA
REGISTERED LAND SURVEYOR
NO. 4781
JAMES R. FREELAND

RLS: JAMES R. FREELAND
NO. 4781

STATE OF SOUTH CAROLINA
GREENVILLE COUNTY

FOREST LAKE
SEC. 1; PHASE 1; LOT 26
PROPERTY OF
D. RENEE FERRELL

FREELAND & ASSOCIATES
Engineers • Land Surveyors
318 WEST STONE AVENUE.
GREENVILLE, S.C.
(803) 271-4924

PLAT BOOK	11-1-6
DEED BOOK	
TAX MAP	
PARTY CHIEF	J.C.
DRAWN	I.R.
DATE	3-5-85
DWG NO.	12880