


Note: Improvements on this lot are not in a flooded hazard area.

PROPERTY OF
JESSE H. TATE, JR. & CAROLYN R. TATE
 GREENVILLE, S.C.
 SCALE: 1" = 40' 5 JUNE 1985

Note: There is a 10' drainage & utility easement along all side and rear lot lines.

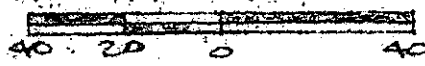

This is to certify that on the 5th day of June, 1985, I surveyed the property shown on this plat, being known as lot 10 on plat of SECTION THREE STONE LAKE and recorded in the REC Office Greenville County, S. C., in Plat Book "QQ" at Page 96; and that the property lines, walls and buildings are as shown hereon, and that the walls and buildings located on said lot do not encroach or project on adjacent street or property, and that no adjacent walls or buildings encroach or project on said premises, and no power lines cross this property except as shown hereon.

FILED
 GREENVILLE CO.
 JUN 24 9 30 AM 1985
 DONNIE S. JARRENS
 R.M.C.

11-R-29

39170

R. B. Bruce
 R. B. Bruce, RLS # 1952

CAROLINA SURVEYING CO. Recordable Plat
 112 Manly St. Greenville, S.C.