


FILED-
GREENVILLE CO. S.C.

JUN 24 11 43 AM '85

DONNIE S. TANKERSLEY
R.M.C.

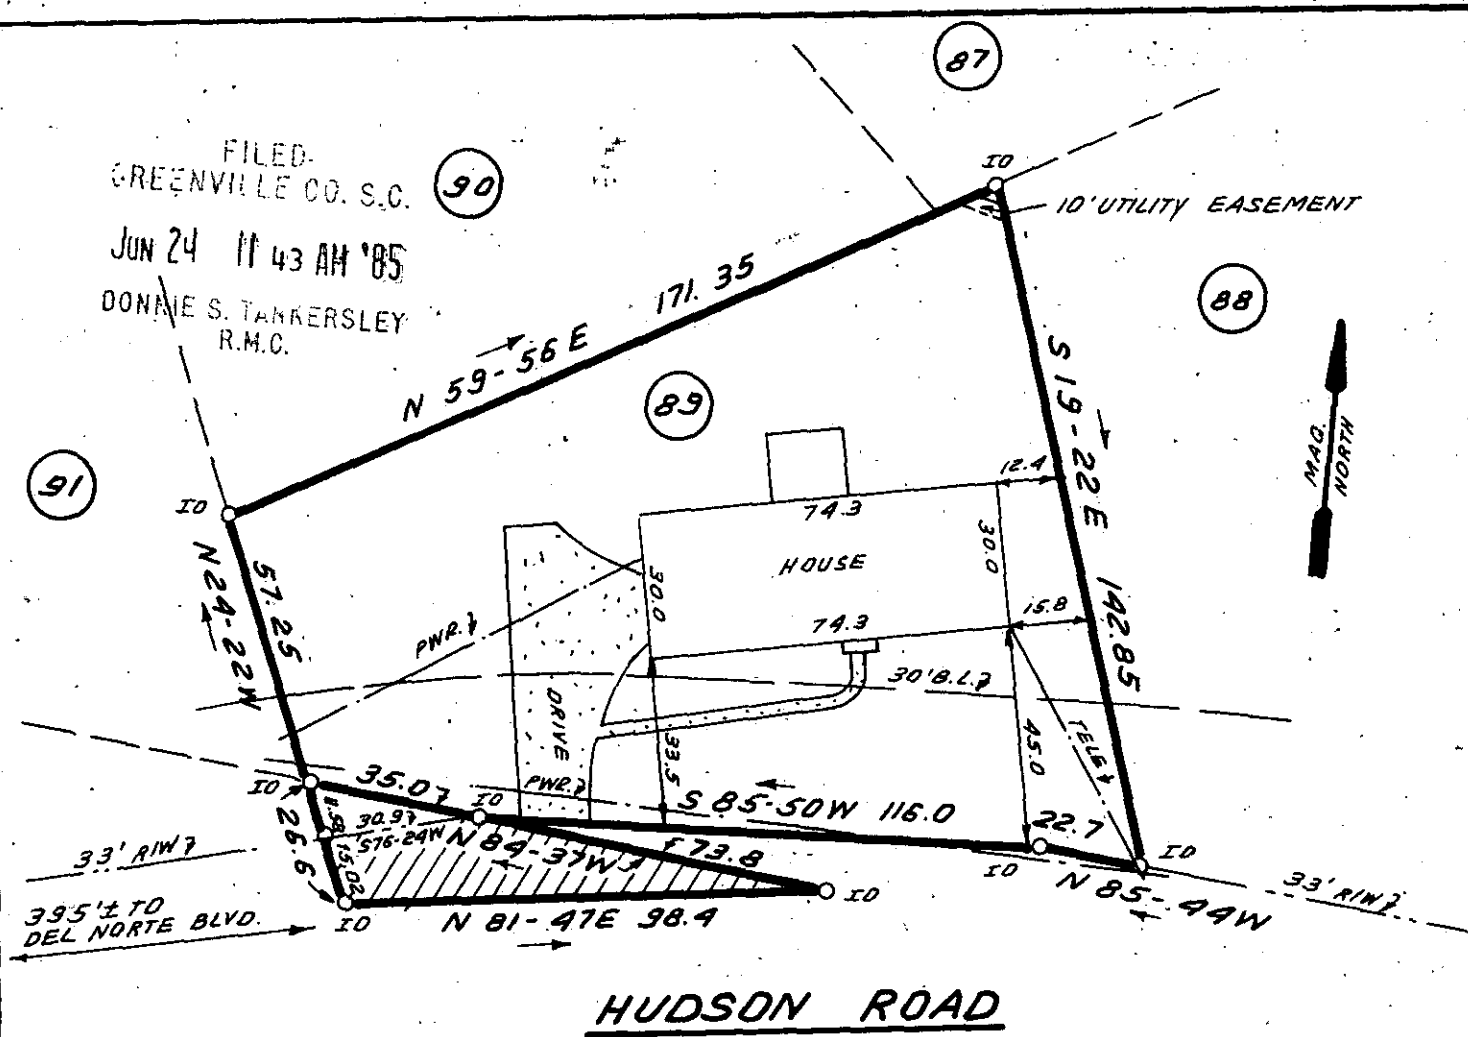

HUDSON ROAD

NOTE: THE CROSSED HATCHED
AREA FALLS IN R/W
OF HUDSON ROAD.


11-R-31

JUN 24 1985

39169



THIS IS TO CERTIFY THAT THE PROPERTY SHOWN ON THIS PLAT WAS SURVEYED UNDER MY DIRECT SUPERVISION. PROPERTY LINES AND IMPROVEMENTS SHOWN ARE LOCATED CORRECTLY AND THAT NO VISIBLE ENCROACHMENTS EXIST UNLESS OTHERWISE SHOWN. THIS PROPERTY IS NOT LOCATED IN A DESIGNATED FLOOD HAZARD AREA.

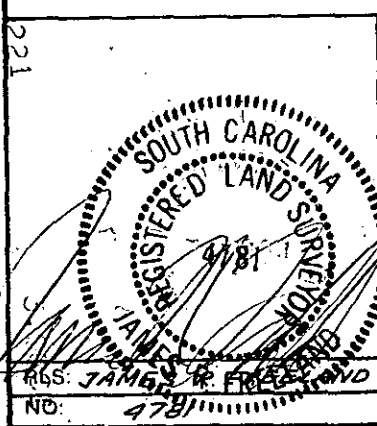

**STATE OF SOUTH CAROLINA
GREENVILLE COUNTY**

DEL NORTE ESTATE
SEC. 4 ; LOT. 89
PROPERTY OF
FRANKLIN ENTERPRISES, INC.

FREELAND & ASSOCIATES
Engineers • Land Surveyors
318 WEST STONE AVENUE.
GREENVILLE, S.C.
(803) 271-4924

PLAT BOOK 4N-8
DEED BOOK 1056 - 873
TAX MAP 538.9-1-158
PARTY CHIEF
DRAWN B.R.
DATE 6-12-85
DWG. NO. 13194