


PROPERTY OF
 JERRY W. HENRY & PHYLLIS HENRY
 NEAR GREENVILLE, S.C.
 SCALE: 1"=40' 10 JUNE 1985

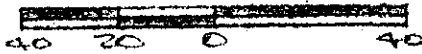

This is to certify that on the 10th day of June, 1985, I surveyed the property shown on this plat, being known as lot 20 on plat of NORTH ACRES and recorded in the RMC Office Greenville County, S. C., in Plat Book "EE" at Page 13; and that the property lines, walls and buildings are as shown hereon, and that the walls and buildings located on said lot do not encroach or project on adjacent street or property, and that no adjacent walls or buildings encroach or project on said premises, and no power lines cross this property except as shown hereon.

JUN 25 1985

39404 / 11R-42

R. B. Bruce
 R. B. Bruce, R.L. # 1952

CAROLINA SURVEYING CO.
 112 Manly St.
 Greenville, S. C.

Recordable Plat