
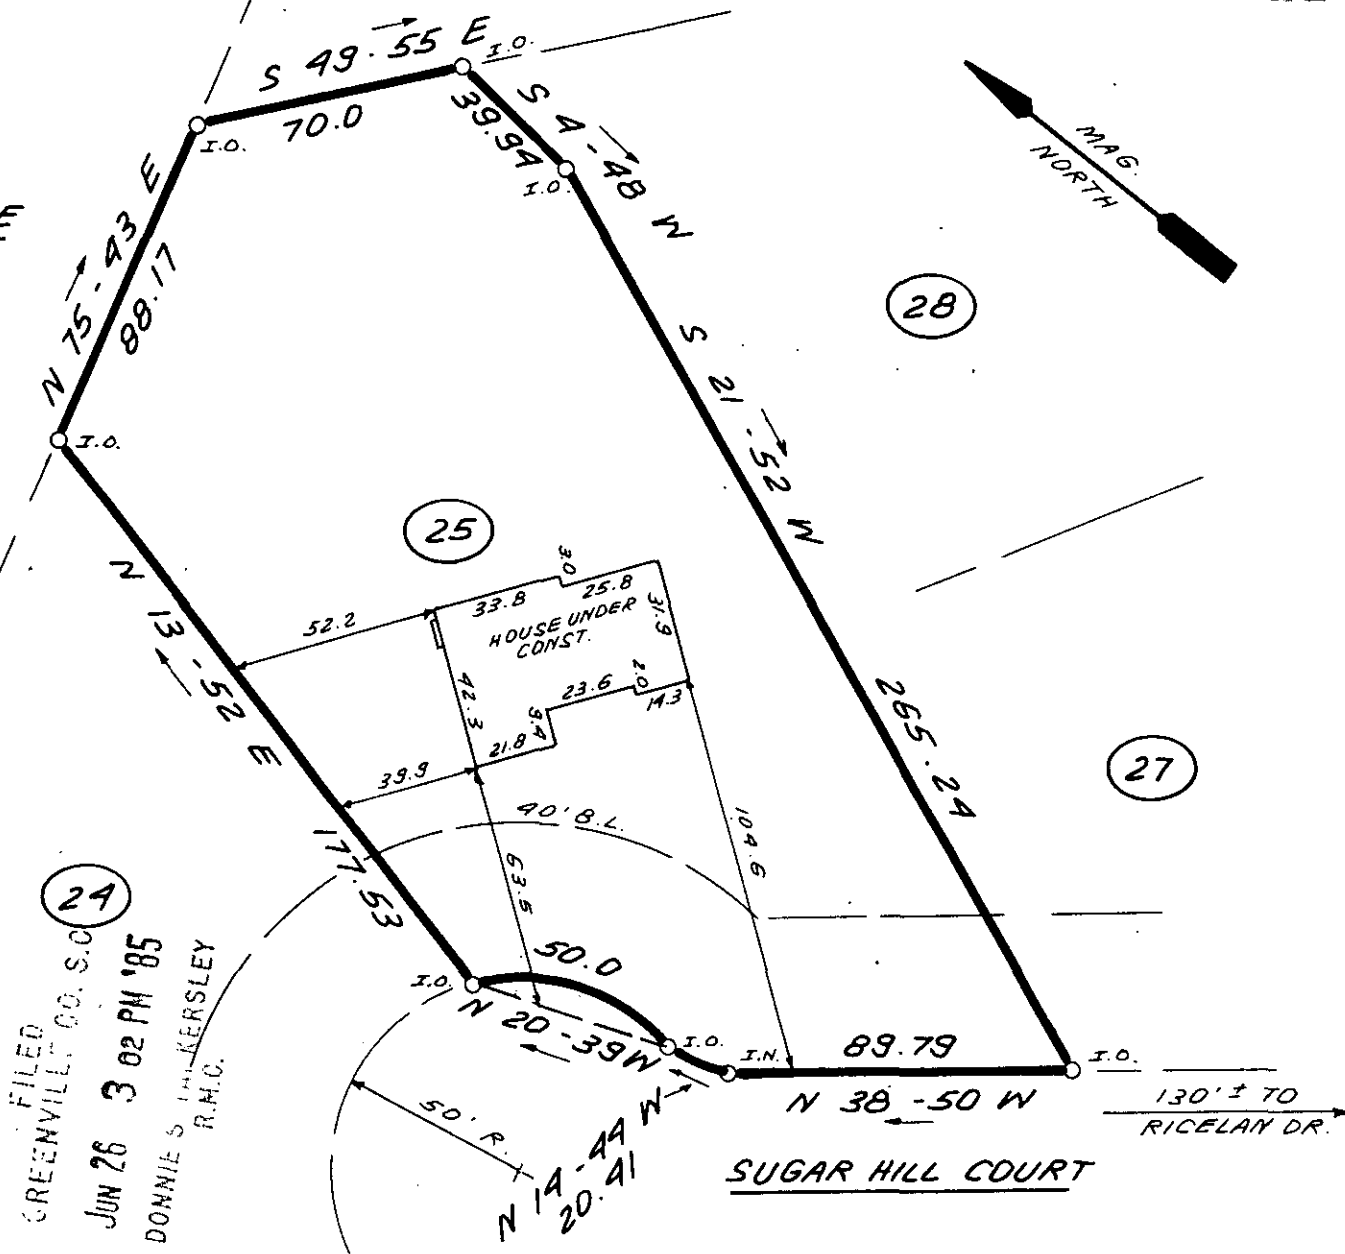


RICE

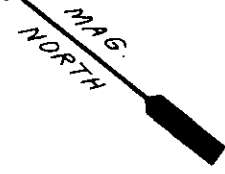

FILED
 GREENVILLE CO. S.C.
 JUN 26 3 02 PM '85
 DONNIE S. WALKERSLEY
 R.M.C.

NOTE:
 5' DRAINAGE & UTILITY EASEMENT
 ALONG EACH SIDE ALL SIDE & REAR
 LOT LINES.

SCALE 1" = 50'
 FEET

THIS IS TO CERTIFY THAT THE PROPERTY SHOWN ON THIS
 PLAT WAS SURVEYED UNDER MY DIRECT SUPERVISION.
 PROPERTY LINES AND IMPROVEMENTS SHOWN ARE LOCATED
 CORRECTLY AND THAT NO VISIBLE ENCROACHMENTS EXIST
 UNLESS OTHERWISE SHOWN. THIS PROPERTY IS NOT LOCATED
 IN A DESIGNATED FLOOD HAZARD AREA.

SOUTH CAROLINA
REGISTERED LAND SURVEYOR
JAMES R. FREELAND

RLS: JAMES R. FREELAND
 NO: 4781

STATE OF SOUTH CAROLINA
GREENVILLE COUNTY

11-R-47 RICELAN CREEK
LOT 25
39535 SURVEY FOR
JOHN D. TULLEY
MARY ANN TULLEY

JUN 26 85

FREELAND & ASSOCIATES
 Engineers • Land Surveyors
 318 WEST STONE AVENUE,
 GREENVILLE, S.C.
 (803) 271-4924

| | |
|-------------|----------|
| PLAT BOOK | 3N @ B |
| DEED BOOK | |
| TAX MAP | |
| PARTY CHIEF | J.C.C. |
| DRAWN | K.E.G. |
| DATE | 6-9-85 |
| DWG NO. | 13140-25 |