MICROFILMED

FILED
GREENVILLE CO. S. C.
JUN 27 10 56 AM '85
DONNIE S. TANKERSLEY
R.M.C.

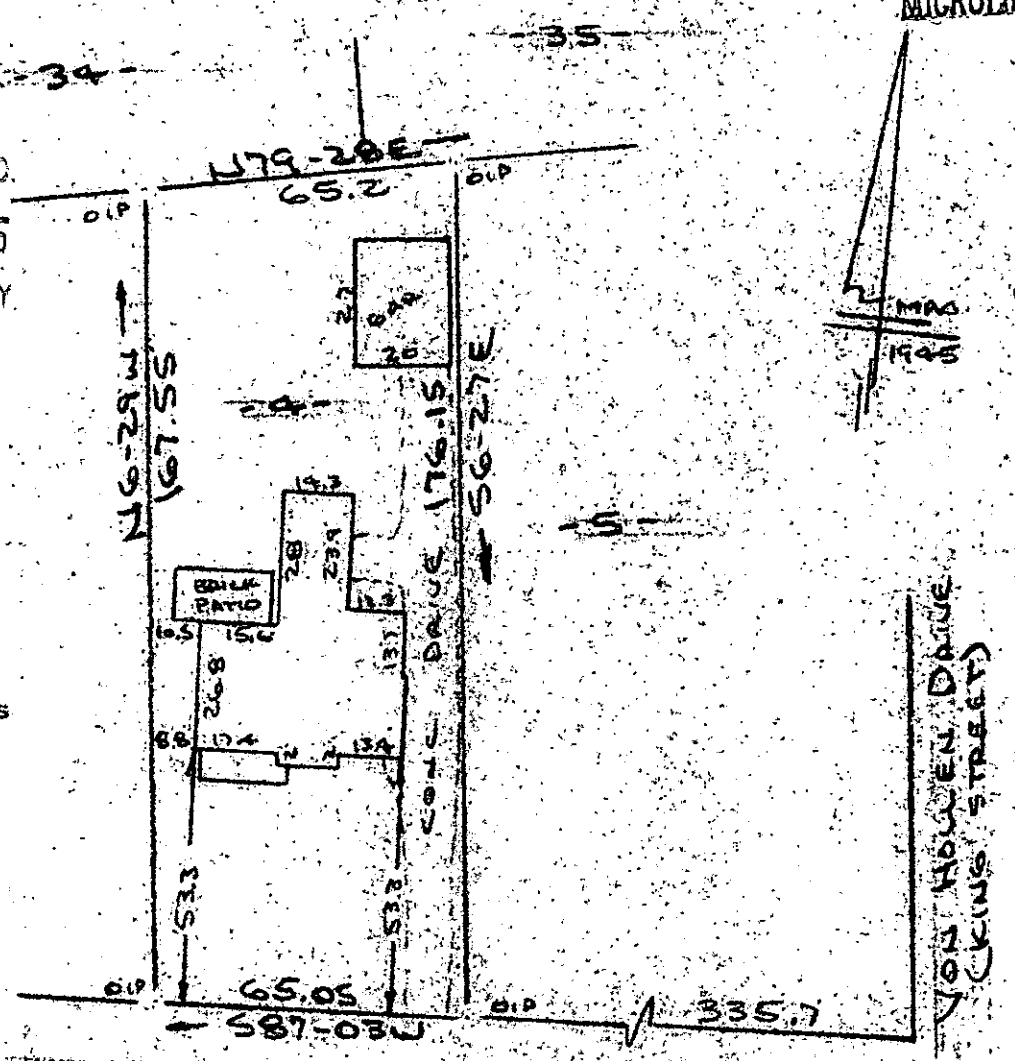

Note:
Improvements on this lot are not in a flood hazard area.

BLUE RIDGE DRIVE
WATER & SEWER IN ST R/W

PROPERTY OF
WALTER B. SWINDLE, JR. & JAMES C. ALEXANDER
NEAR GREENVILLE, GREENVILLE CO., S.C.
SCALE 1"=40' 19 JUNE 1985

40 20 0 40

This is to certify that on the 19th day of June, 1985, I surveyed the property shown on this plat, being known as lot 4 on plat of PERRY ESTATE and recorded in the RMC Office Greenville County, S. C., in Plat Book " K " at Page 95 and also known as PROPERTY OF WALTER B. SWINDLE, JR. & JAMES C. ALEXANDER and recorded in Plat Book at Page ; and that the property lines, walls and buildings are as shown hereon, and that the walls and buildings located on said lot do not encroach or project on adjacent street or property, and that no adjacent walls or buildings encroach or project on said premises, and no power lines cross this property except as shown hereon.

39625

11-R-553

JUN 27 1985

R. B. Bruce, RLS #1952

Recordable Plat

CAROLINA SURVEYING CO.
112 Manly St.
Greenville, S. C.

R. B. BRUCE
SURVEYOR

287/50

16-6-22