

FILED
 GREENVILLE, S.C.
 JUN 28 10 46 AM '85
 DONNIE S. BRUCE

HILLCREST AVE
 WATER ESEWER IN ST. R/W

Note:
 Improvements on
 this lot are not
 in a flood hazard
 area.


PROPERTY OF
PATRICIA W. CASHION
 SIMPSONVILLE, S.C.
 SCALE: 1" = 40' 24 JUNE 1985

This is to certify that on the 24th day of June, 1985, I surveyed the property shown on this plat, being known as lot 1 on plat of PROPERTY OF ROSA G. MOORE and recorded in the REC Office Greenville County, S. C., in Plat Book "FF" at Page 411; and that the property lines, walls and buildings are as shown hereon, and that the walls and buildings located on said lot do not encroach or project on adjacent street or property, and that no adjacent walls or buildings encroach or project on said premises, and no power lines cross this property except as shown hereon.

39898

11-R-59
 JUN 28 1985

R. B. Bruce
 R. B. Bruce, RLS # 1952

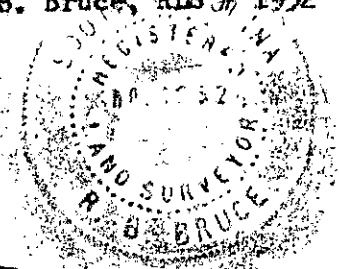

CAROLINA SURVEYING CO.
 112 Manly St.
 Greenville, S. C.

Recordable Plat

300 3
 1A01