
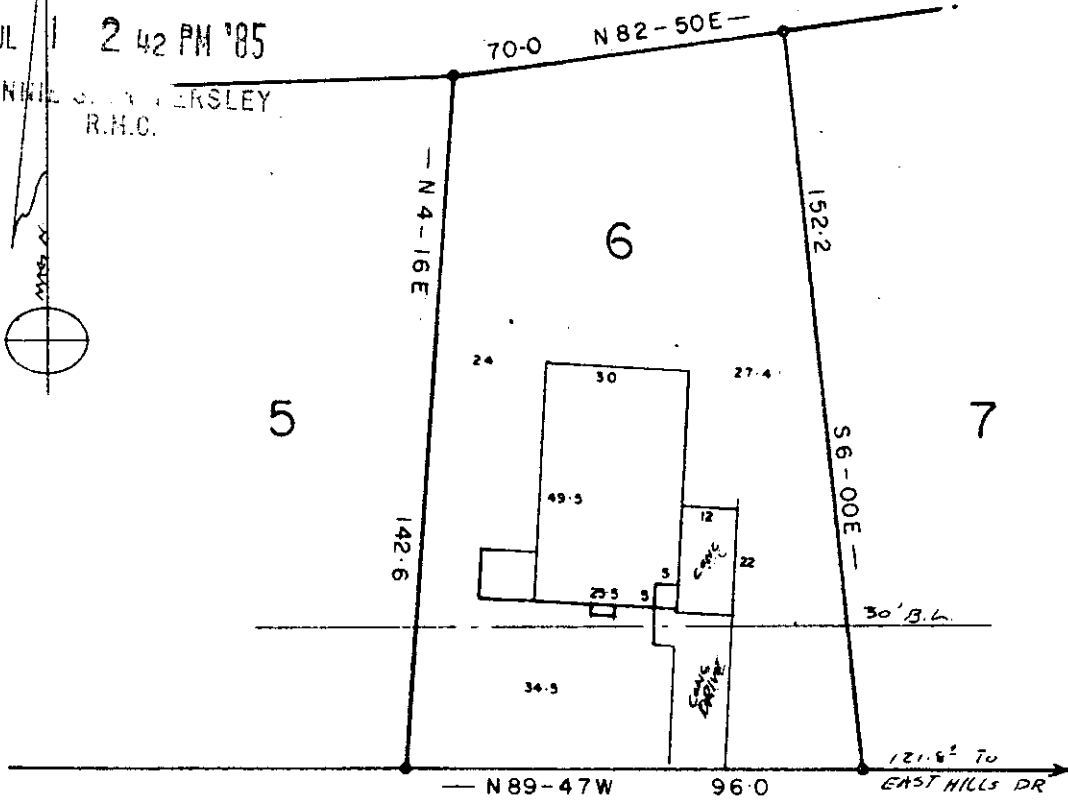


FILED
GREENVILLE CO. S.C.

JUL 1 2 42 PM '85

DONALD S. JONES
R.H.C.

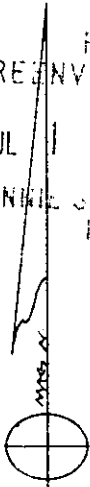

WALKER SPRINGS ROAD

NOTE THIS LOT DOES NOT LIE IN A FLOOD PLANE.

JUL 1 1985

227 ✓

11-R-79

PROPERTY OF


~~This is~~ to certify that on the 26 day of JUNE
I, the undersigned, have surveyed the property shown on this plat,
being:

PATRICIA S. DAVIDSON

GREENVILLE CO., S. C.

and recorded in GREENVILLE, page 29 of the R.H.C. County, S. C.

Office for
and that the property lines, walls
and buildings are as shown herein;
that the buildings located on said
lot do not encroach or project on
adjacent streets or property; and
that no adjacent buildings or walls
encroach or project on said premises,
and that no utility lines cross this
property unless shown on plat.

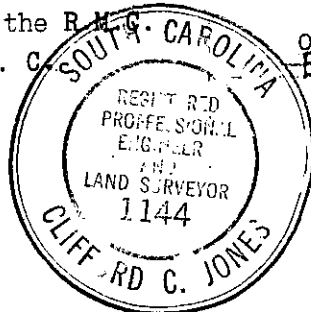

JUNE 26, 1985 SCALE 1" = 40'

